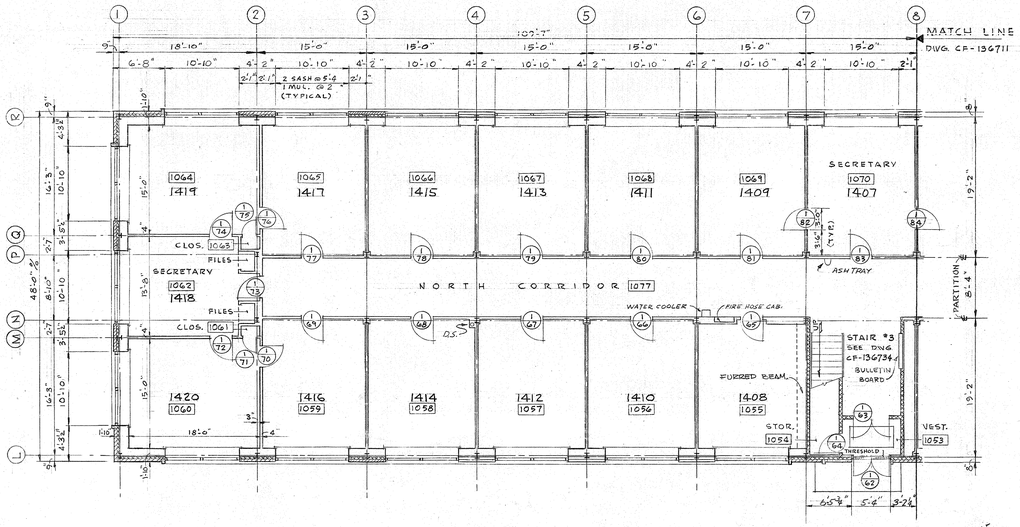

NORTH WEST WING

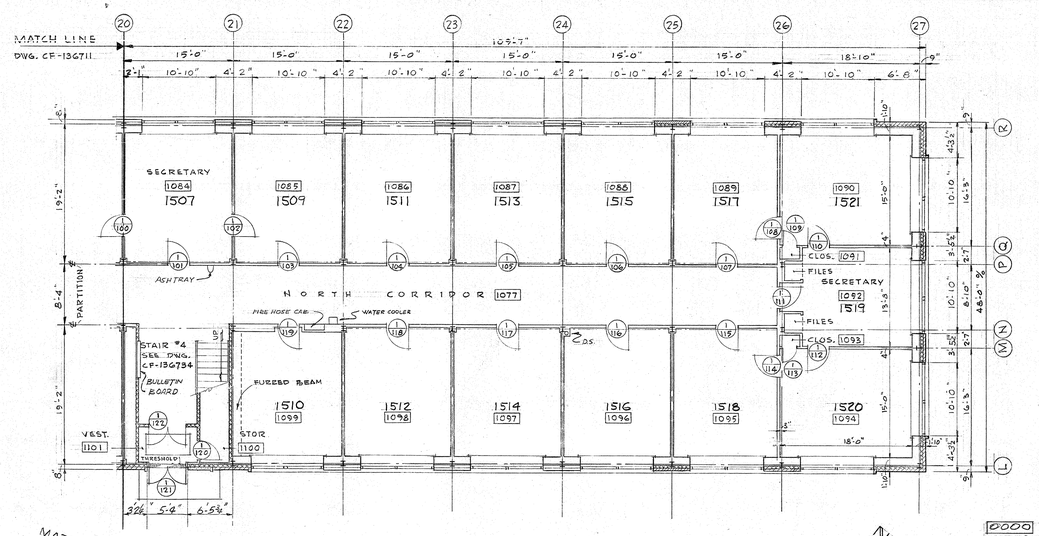

NORTH EAST WING

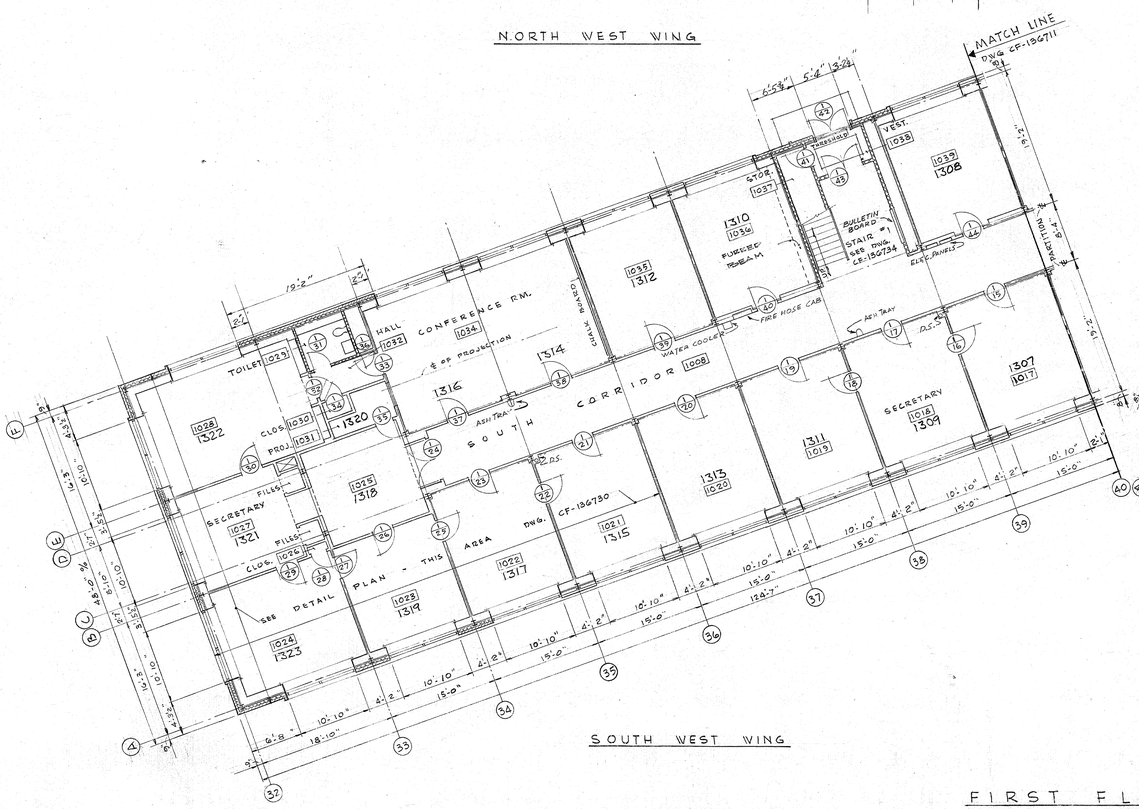

SOUTH WEST WING

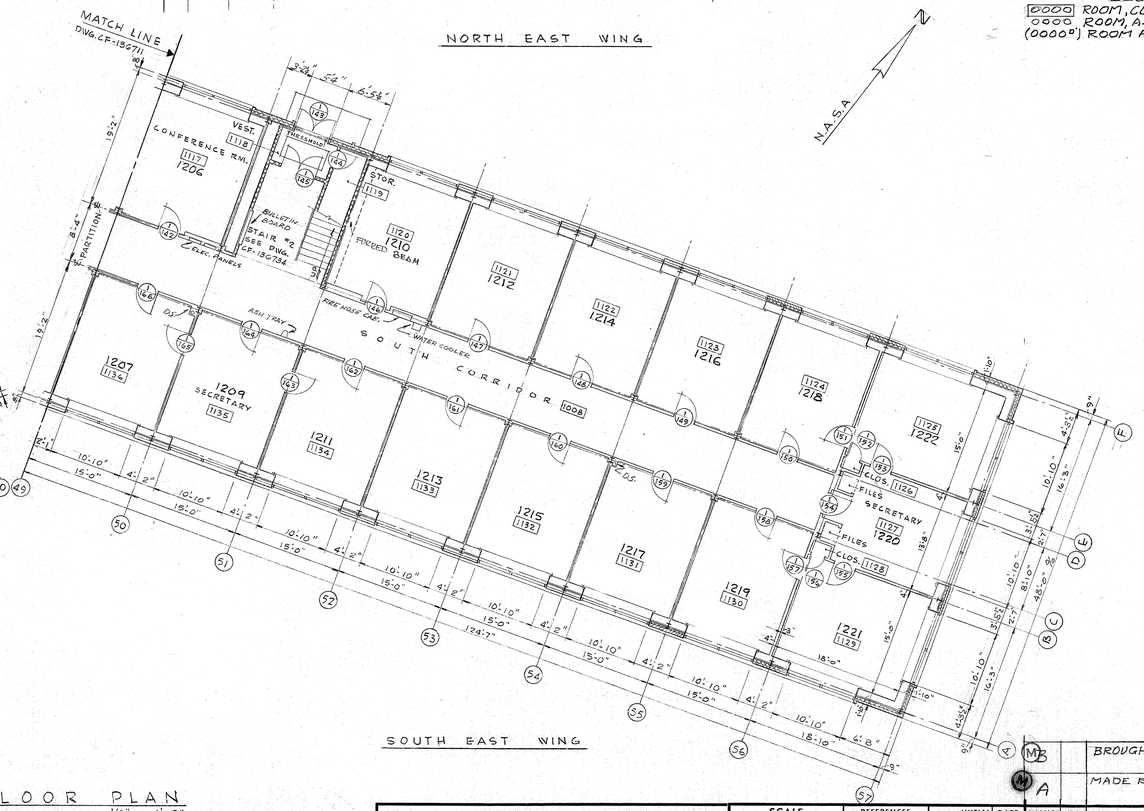

SOUTH EAST WING

LEGEND
0000 ROOM, CONSTRUCTION NUMBER
0000 ROOM, ASSIGNED NUMBER
(0000°) ROOM AREA, SQUARE FEET

N.A.S.A.

FIRST FLOOR PLAN
SCALE 1/8" = 1'-0"

CHANGE NO.	REVISION	DATE	CK. APP.
MB	BROUGHT UP TO DATE	6-23-66	ALH
A	MADE RECORD DRAWING	2-12-63	ALH.

HUBBELL & BENES and HOFF, INC.
ARCHITECTS & ENGINEERS
1922 E. 107th St. CLEVELAND 6, OHIO

DESIGNED BY— E.L. & J.K. CHECKED BY— J.W.M. APPROVED BY— [illegible]
DATE 7-30-62 JOB NO. 62303 SHEET ACCOUNT NO. 0105

SCALE 1/8" = 1'-0"
UNLESS OTHERWISE SPECIFIED
.X DIM. MAY VARY ±
.XX DIM. MAY VARY ±
.XXX DIM. MAY VARY ±
ANGULAR DIM. MAY VARY ±
_____ DIM. MAY VARY ±
BREAK SHARP EDGES.

REFERENCES		INITIAL	DATE
JO 11806	DR.		
C-8470	CK.		
	D.ENG.	EL	
	R.ENG.		
	P.ENG.	JK	
	D.S.HD.	JW	
SAFETY APPROVAL	R.S.HD.	[illegible]	
BY DATE	D.D.CH.	[illegible]	9/16/62
AREA___SAFETY COMM.	R.D.CH.		

DEVELOPMENT ENGINEERING BUILDING PROJECT
STRUCTURES- ROADS- UTILITIES
ARCHITECTURAL
DEVELOPMENT ENGINEERING BUILDING
FIRST FLOOR PLAN WINGS

NATIONAL AERONAUTICS AND SPACE ADMINISTRATION
LEWIS RESEARCH CENTER
CLEVELAND, OHIO

DWG. NO. CF-136712

STATE OF OHIO JOHN G. KISH 954 REGISTERED ARCHITECT

ARCH. STRUC. RECORD DWG.
CHANGES TO BE MADE BY AUTHORIZED DRAFTSMEN ONLY