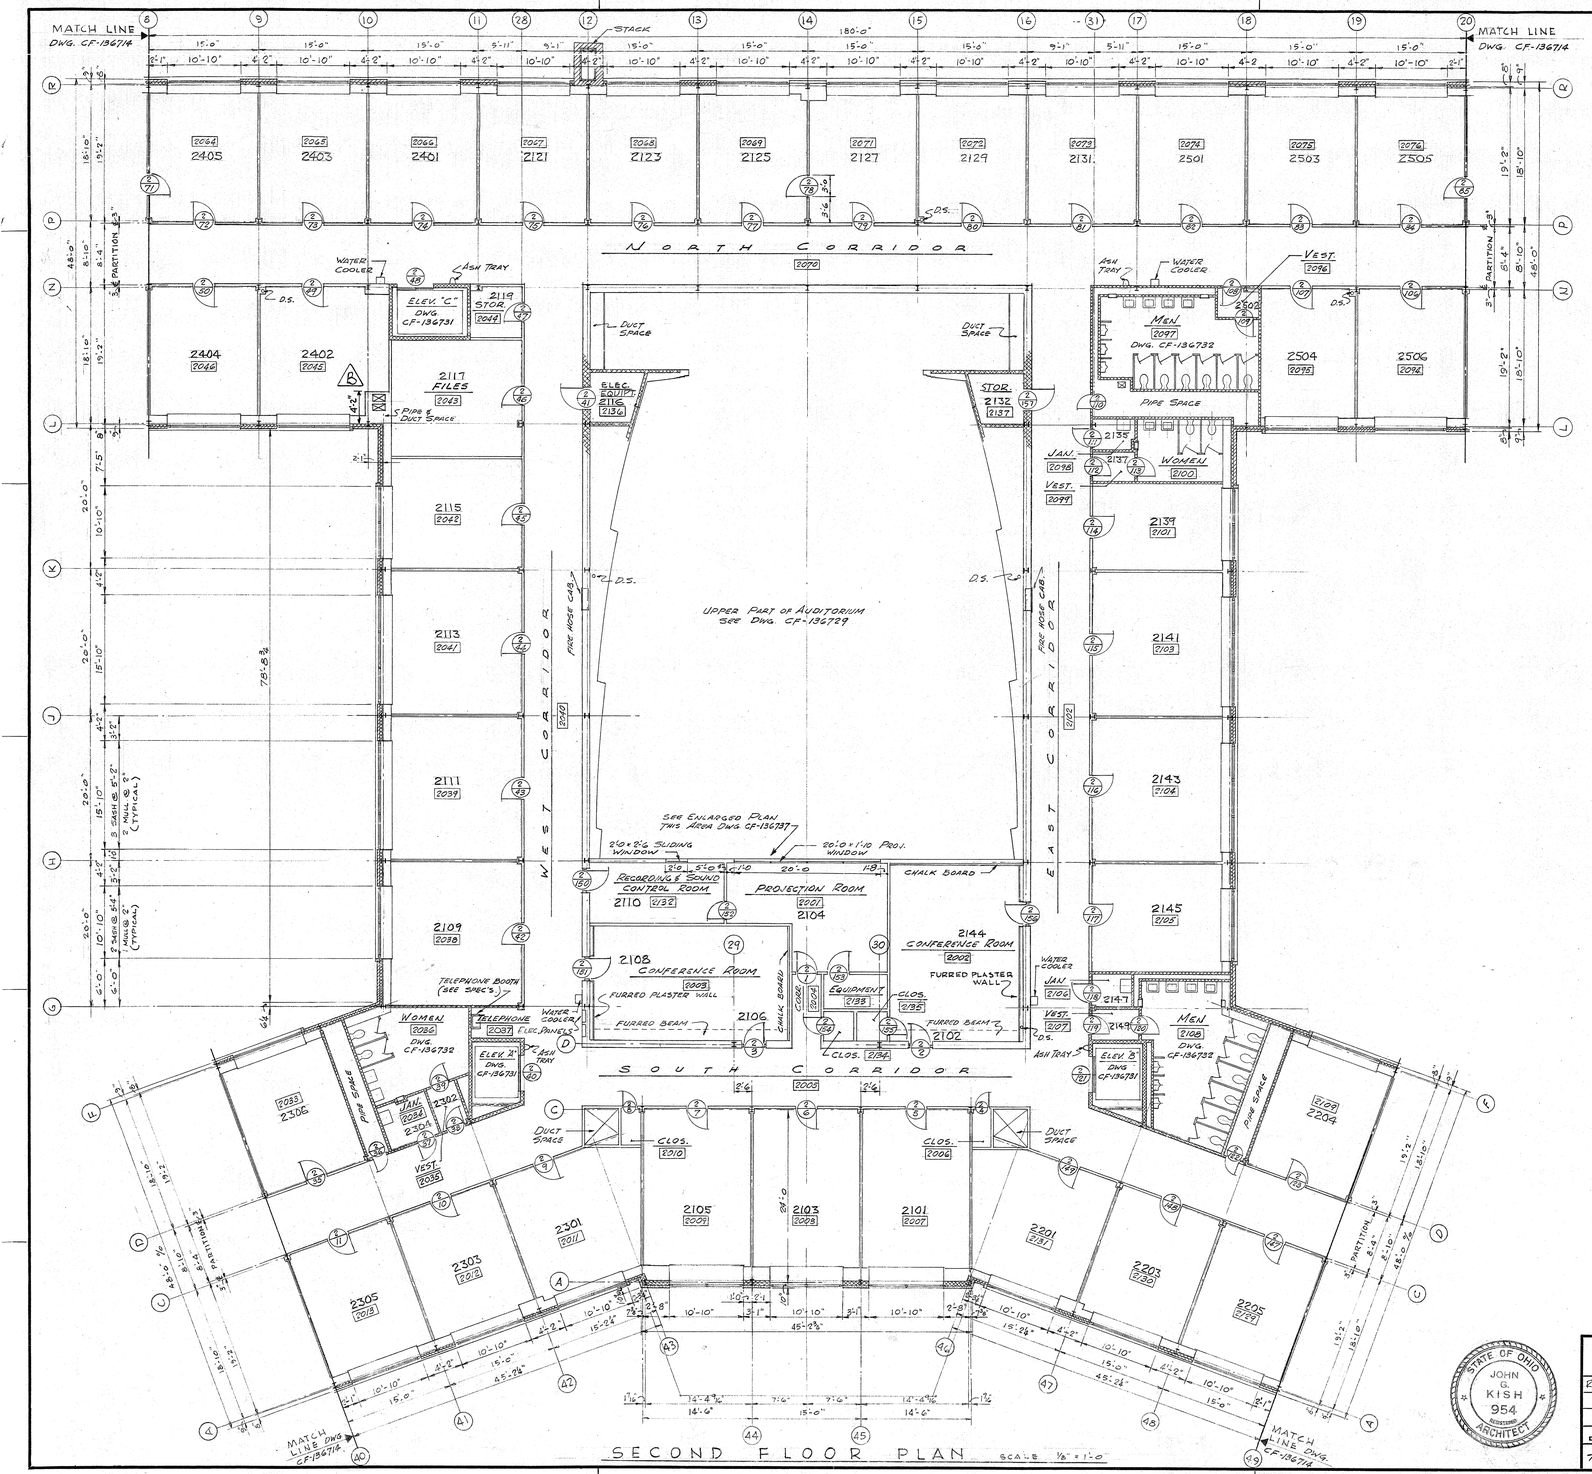

SECOND FLOOR PLAN SCALE 1/8" = 1'-0"

LEGEND
0000 ROOM, CONSTRUCTION NUMBER
0000 ROOM, ASSIGNED NUMBER
0000□' ROOM AREA, SQUARE FEET.

CHANGE NO.	REVISION	DATE	CK. APP.
C	BROUGHT UP TO DATE	6-22-66	ALH
B	PIPE & DUCT SPACE ENLARGED	3-13-63	
A	MADE RECORD DRAWING	2-11-63	ALH

HUBBELL & BENES and HOFF, INC.
ARCHITECTS & ENGINEERS
1922 E. 107th St. CLEVELAND 6, OHIO

REV. B - 3/4/63 APPROVED JGK 3/13/63

DESIGNED BY— E.L. CHECKED BY— J.W.M. APPROVED BY— JGK

DATE 7-30-62 JOB NO. 62303 SHEET ACCOUNT NO. 0108

SCALE 1/8" = 1'-0"

UNLESS OTHERWISE SPECIFIED
.X DIM. MAY VARY ±
.XX DIM. MAY VARY ±
.XXX DIM. MAY VARY ±
ANGULAR DIM. MAY VARY ±
____ DIM. MAY VARY ±
BREAK SHARP EDGES

REFERENCES
JO 11806
C-5470

SAFETY APPROVAL BY DATE AREA SAFETY COMM.

	INITIAL	DATE
DR.		
CK.		
D.ENG.	EAL	
R.ENG.		
P.ENG.		
D.S.HD.		
R.S.HD.		
D.D.CH.		8-16-62
R.D.CH.		

DEVELOPMENT ENGINEERING BUILDING PROJECT
STRUCTURES - ROADS - UTILITIES
ARCHITECTURAL
DEVELOPMENT ENGINEERING BUILDING
SECOND FLOOR PLAN CENTER CORE

NATIONAL AERONAUTICS AND SPACE ADMINISTRATION
LEWIS RESEARCH CENTER
CLEVELAND, OHIO

DWG. NO. CF-136713

ARCH. STRUC. RECORD DWG.
CHANGES TO BE MADE BY AUTHORIZED DRAFTSMEN ONLY