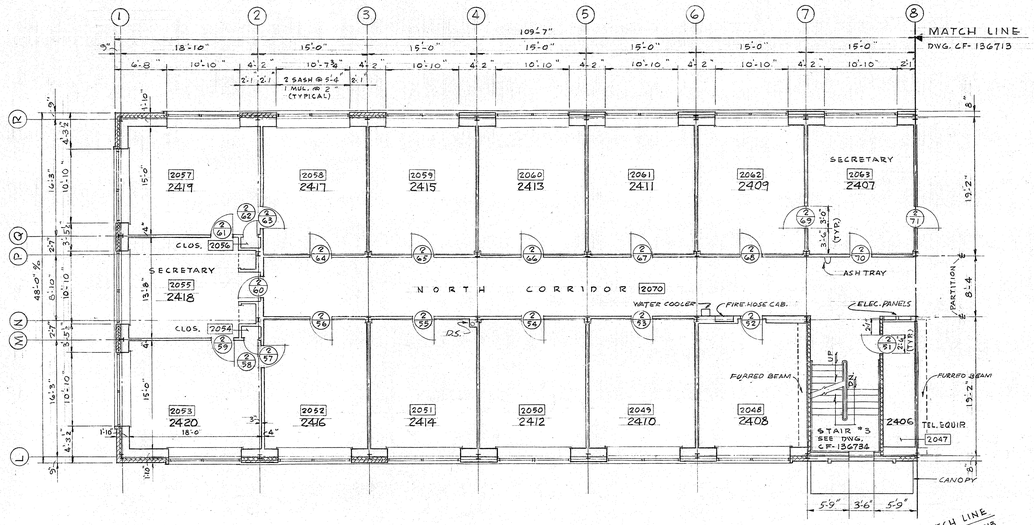

NORTH WEST WING

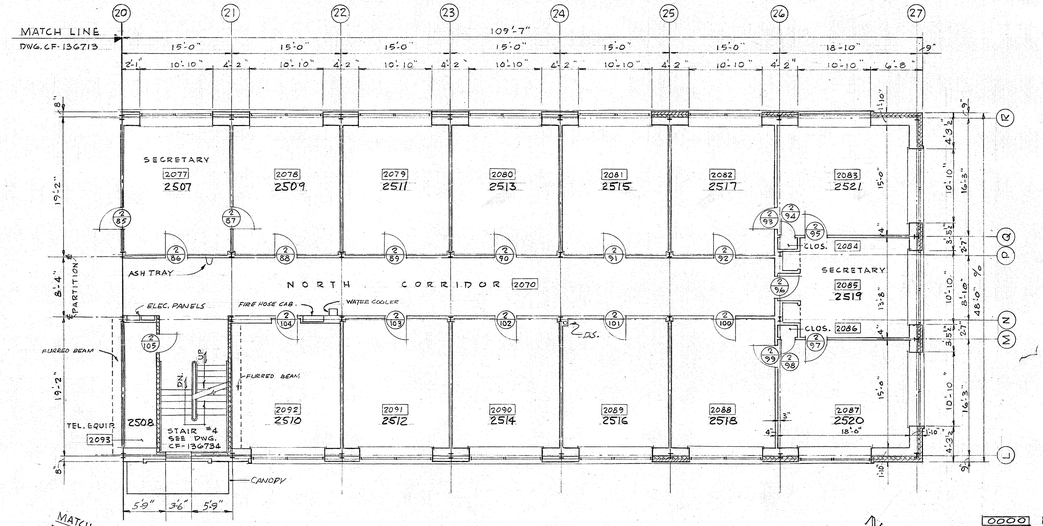

NORTH EAST WING

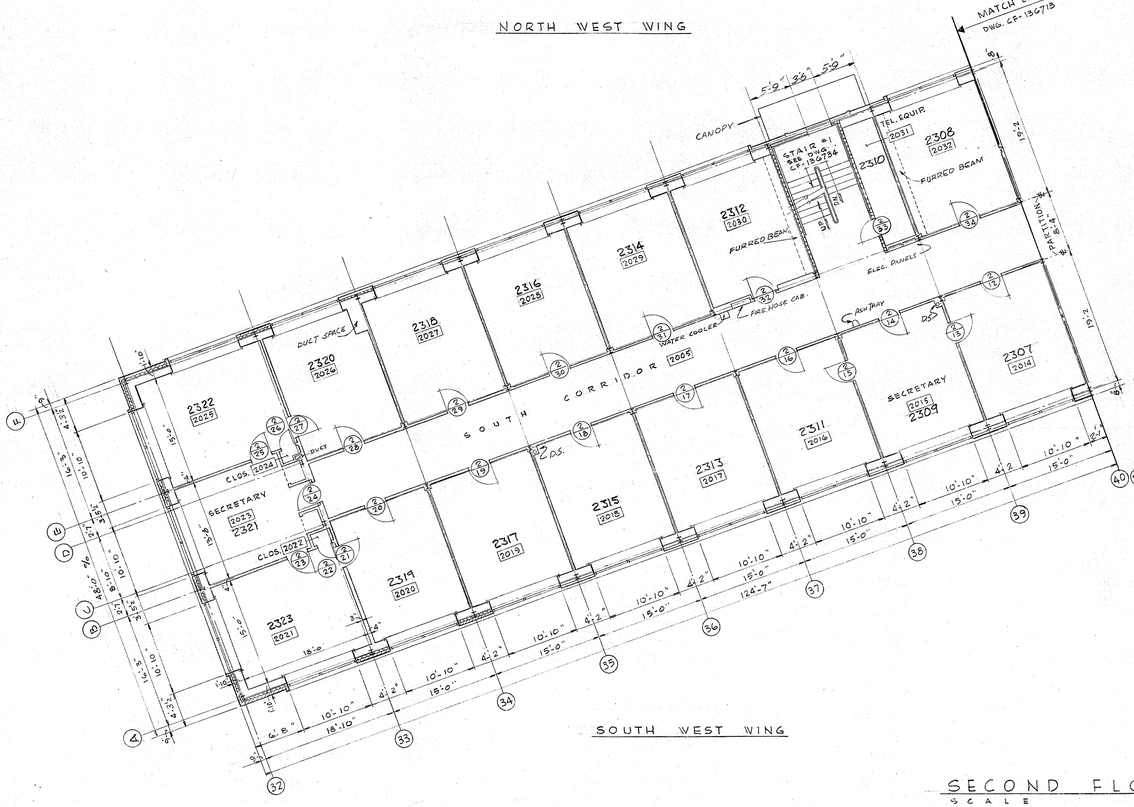

SOUTH WEST WING

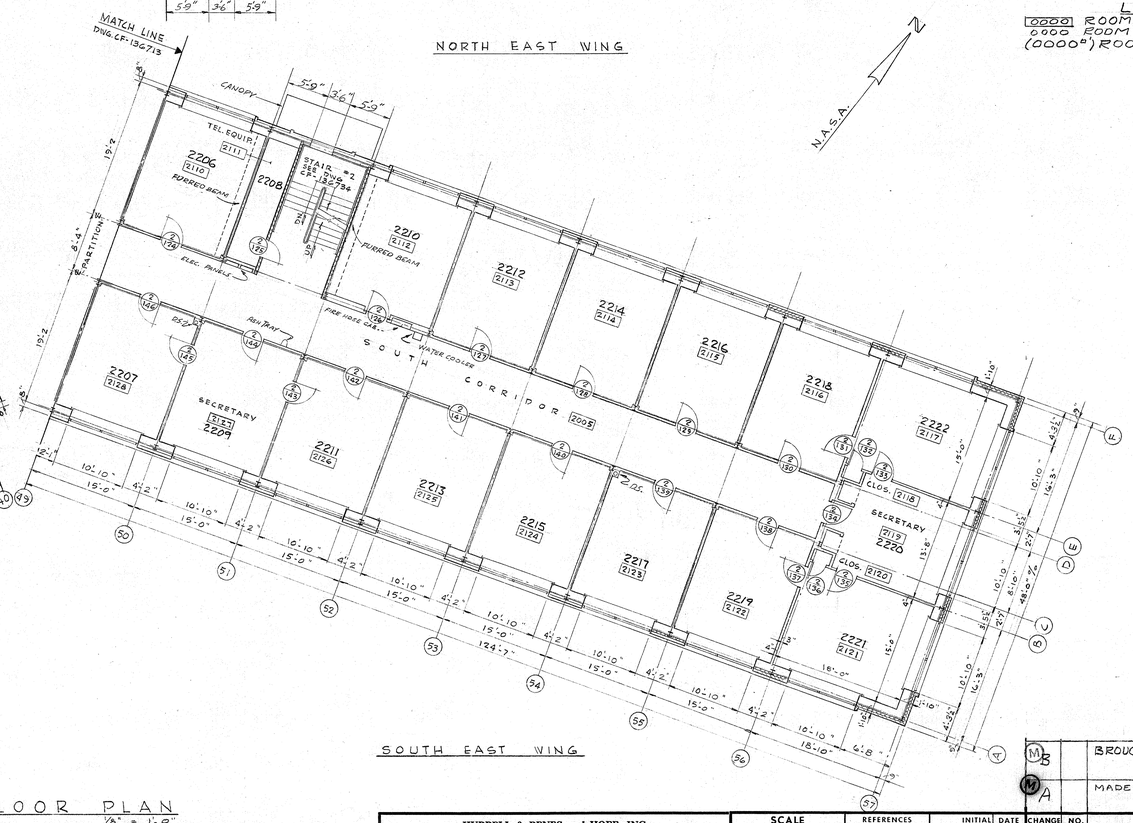

SOUTH EAST WING

SECOND FLOOR PLAN

SCALE 1/8" = 1'-0"

LEGEND

[0000] ROOM-CONSTRUCTION NUMBER
0000 ROOM-ASSIGNED NUMBER.
(0000°) ROOM AREA-SQUARE FEET

STATE OF OHIO JOHN G. KISH 954 REGISTERED ARCHITECT

MB		BROUGHT UP TO DATE	6-24-66	ALH
MA		MADE RECORD DRAWING	2-7-63	ALH
CHANGE	NO.	REVISION (M)	DATE	CK. APP.

HUBBELL & BENES and HOFF, INC.
ARCHITECTS & ENGINEERS
1922 E. 107th St. CLEVELAND 6, OHIO

DESIGNED BY- JK CHECKED BY- J.W.M. APPROVED BY- J.W.M.
DATE 7-30-62 JOB NO. 62303 SHEET ACCOUNT NO. 0107

SCALE 1/8"=1'-0"
UNLESS OTHERWISE SPECIFIED
.X DIM. MAY VARY ±
.XX DIM. MAY VARY ±
.XXX DIM. MAY VARY ±
ANGULAR DIM. MAY VARY ±
____DIM. MAY VARY ±
BREAK SHARP EDGES____

SAFETY APPROVAL BY DATE
AREA__SAFETY COMM.

REFERENCES	INITIAL	DATE
JO 11806	DR.	
C-8470	CK.	
	D.ENG.	
	R.ENG.	
	P.ENG.	
	D.S.HD.	
	R.S.HD.	
	D.D.CH.	
	R.D.CH.	

DEVELOPMENT ENGINEERING BUILDING PROJECT
-STRUCTURES-ROADS-SERVICES
ARCHITECTURAL
DEVELOPMENT ENGINEERING BUILDING 500
SECOND FLOOR PLAN WINGS

NATIONAL AERONAUTICS AND SPACE ADMINISTRATION
LEWIS RESEARCH CENTER
CLEVELAND, OHIO

DWG. NO. CF-136714

ARCH. STRUC. RECORD DWG.
CHANGES TO BE MADE BY AUTHORIZED DRAFTSMEN ONLY