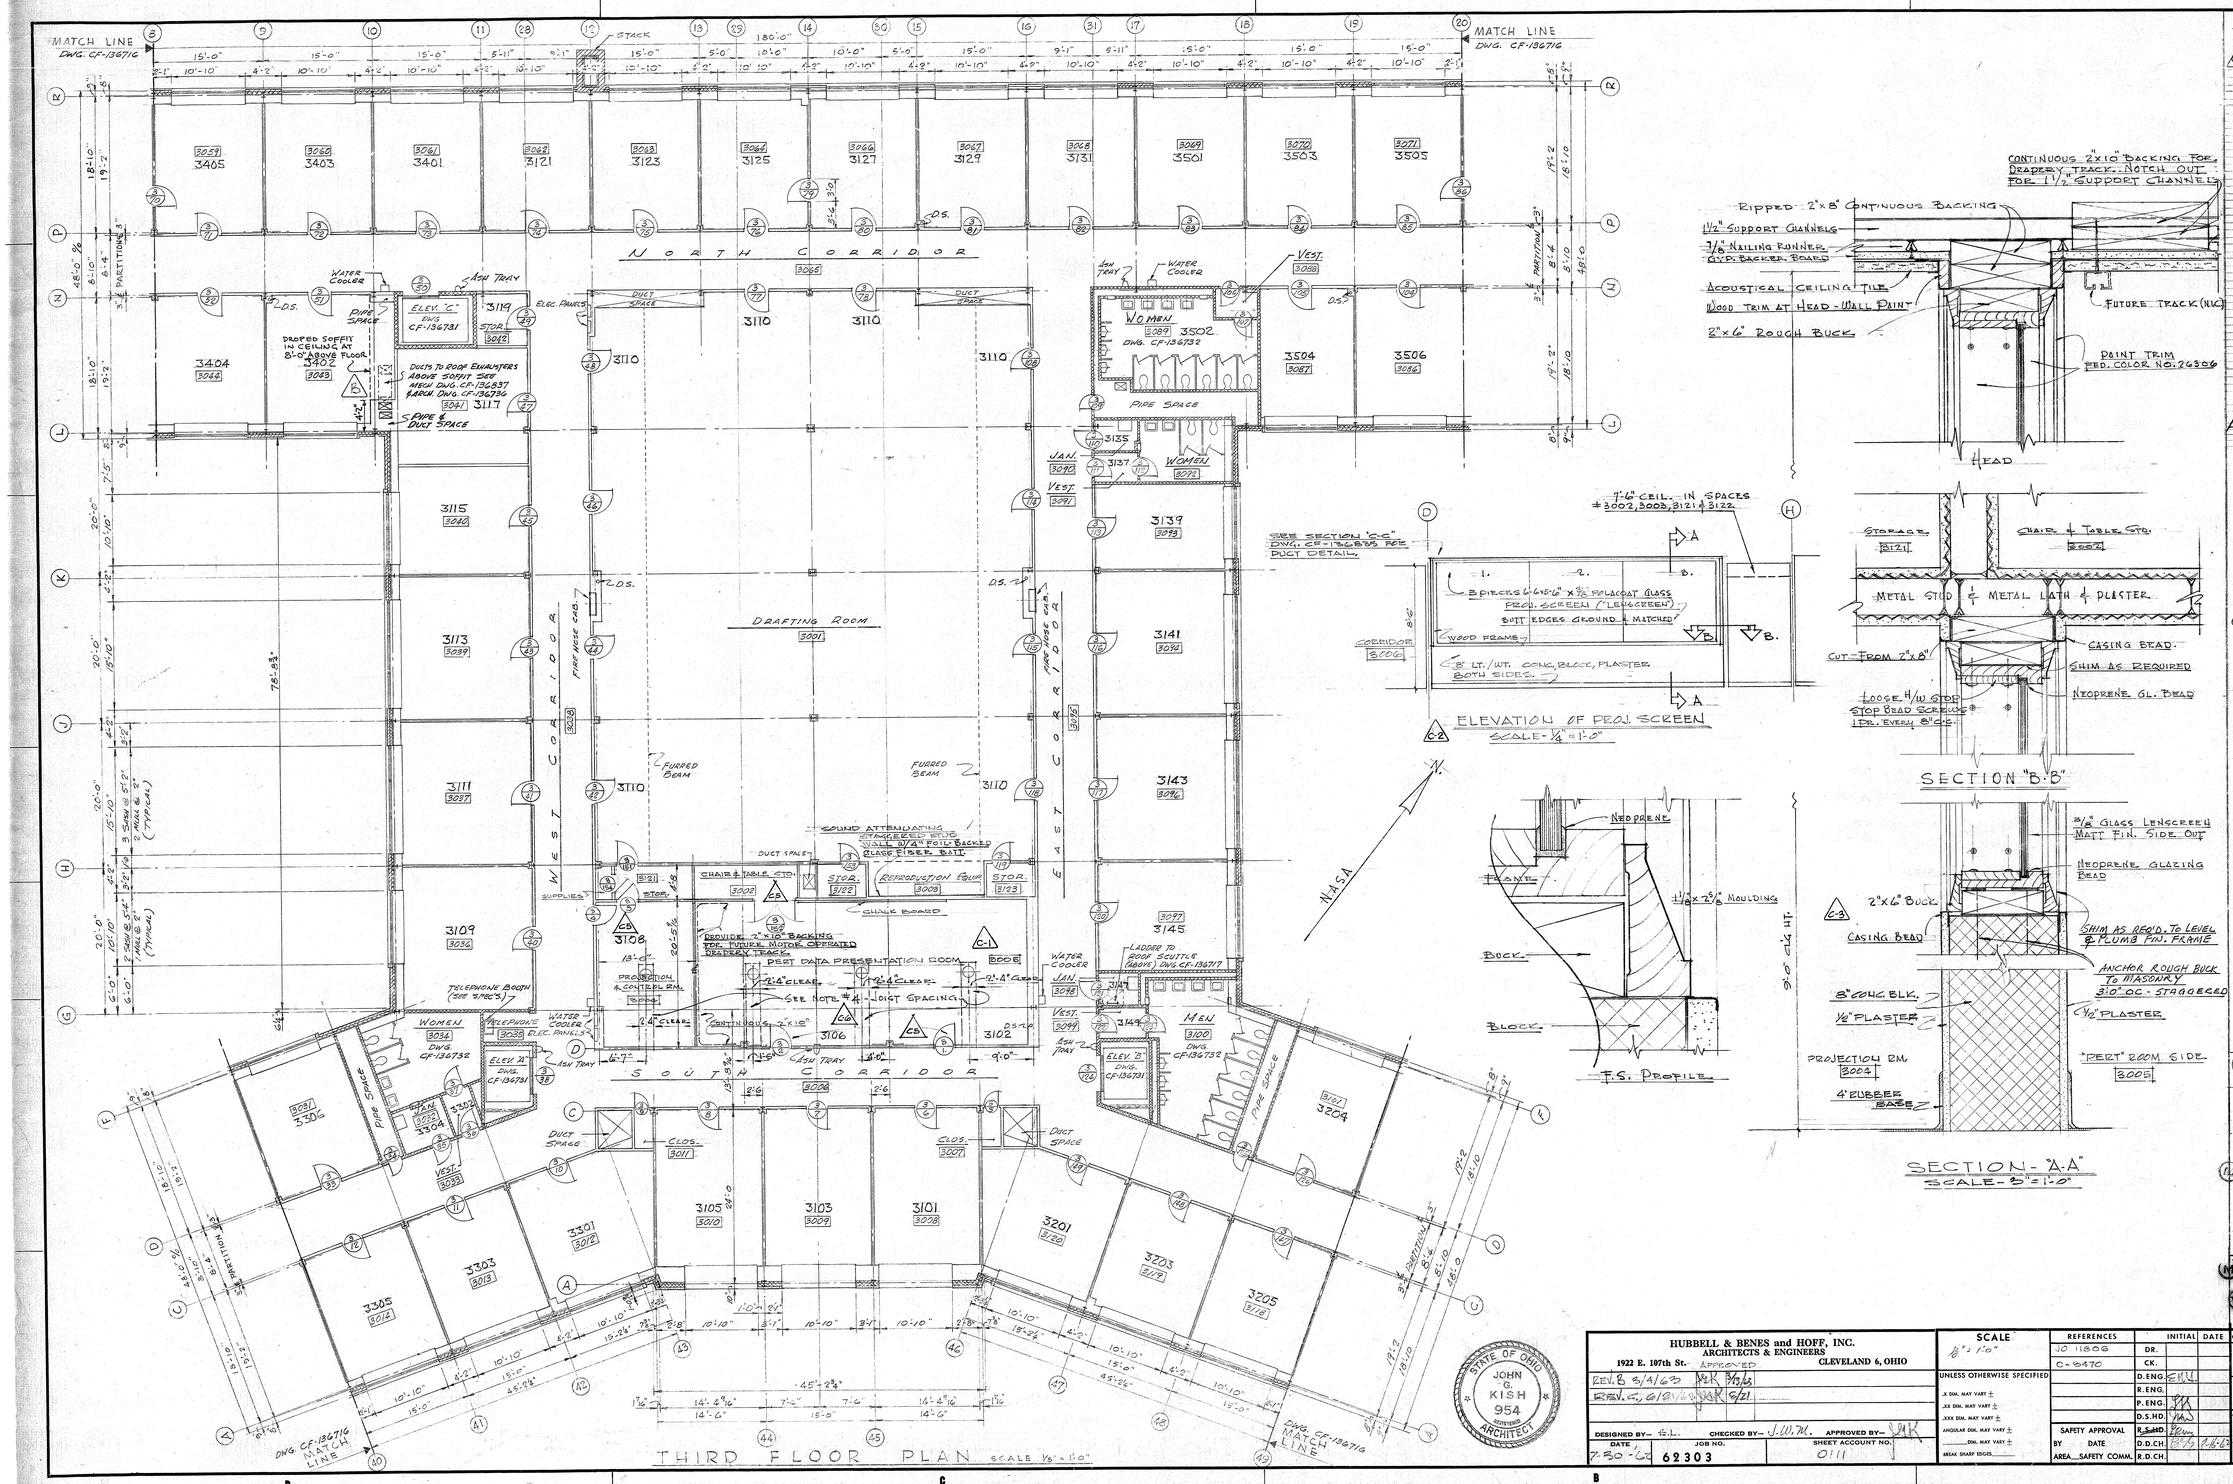

GENERAL NOTES

C4

1. THE REAR PROJECTION SCREEN SHALL BE THREE PIECES OF 3/8" THICK GLASS "LENSCREEN". AS MANUFACTURED BY "POLACOAT INC." 5750 CONKLIN ROAD, BLUE ASH 45, OHIO. PHONE — AREA CODE 513; 791-1300
2. THE THREE PIECES OF "LENSCREEN" (EACH PIECE 6'-6" LONG X 5'-6" HIGH) SHALL HAVE BUTT EDGES GROUND AND POLISHED AND SHALL BE CODED FOR PROPER EDGE MATCHING.
3. GLAZING SHALL BE PERFORMED ACCORDING TO MANUFACTURER'S RECOMENDATIONS TO PREVENT ANY LOADS ACTING ON GLASS, USING A FLEXIBLE CUSHION TO SUPPORT ALL SURFACES SET IN FRAME.
4. ALL FINISH MILLWORK SHALL BE CHERRY WOOD. PAINT FED. COLOR NO. 26306
5. BAR JOIST SHALL BE SPACED SO AS NOT TO INTERFERE WITH LOCATIONS SHOWN FOR 4" x 24" SUPPLY DUCTS + INSULATION. REFER TO MECHANICAL DWG. NO. CF-136835 MAX. SPACING NOT TO EXCEED 3'-2".

LEGEND

0000 ROOM, CONSTRUCTION NUMBER.
0000 ROOM, ASSIGNED NUMBER.
(0000 □') ROOM AREA, SQUARE FEET.

CHANGE NO.	REVISION	DATE	CK. APP.
M	BROUGHT UP TO DATE	6-22-66	ALH
6.	BAR JOIST SPACING STIPULATED.	7-9-63	
5.	DOORS ADDED OR RELOCATED		
4	"LENSCREEN" NOTES ADDED TO THE GENERAL NOTES ON THIS DRAWING.		
3	SECTION THRU FED. SCREEN ADDED.		
2	ELEVATION OF FED. SCREEN ADDED.		
1	CONFERENCE ROOMS CHANGED TO "PERT" ROOM		
B	PIPE & DUCT SPACE ENLARGED & FURRING SOFFIT ADDED	3-13-63	
A	MADE RECORD DRAWING	2-11-63	ALH

HUBBELL & BENES and HOFF, INC.
ARCHITECTS & ENGINEERS
1922 E. 107th St. CLEVELAND 6, OHIO

APPROVED

REV. B 3/4/63 RK 3/13/63
REV. A 6/21/62 RK 6/21

DESIGNED BY— E.L. CHECKED BY— J.W.M. APPROVED BY— RK
DATE 7-30-62 JOB NO. 62303 SHEET ACCOUNT NO. 0111

SCALE 1/8" = 1'-0"

UNLESS OTHERWISE SPECIFIED
.X DIM. MAY VARY ±
.XX DIM. MAY VARY ±
.XXX DIM. MAY VARY ±
ANGULAR DIM. MAY VARY ±
____ DIM. MAY VARY ±
BREAK SHARP EDGES.

REFERENCES		INITIAL	DATE
JO 11806	DR.		
C-6470	CK.		
	D. ENG.	EWL	
	R. ENG.		
	P. ENG.		
	D.S. HD.		
SAFETY APPROVAL	R.S. HD.		
BY DATE	D.D. CH.		7-16-62
AREA SAFETY COMM.	R.D. CH.		

DEVELOPMENT ENGINEERING BUILDING PROJECT
STRUCTURES - ROADS - UTILITIES
ARCHITECTURAL
DEVELOPMENT ENGINEERING BUILDING
THIRD FLOOR PLAN CENTER CORR

NATIONAL AERONAUTICS AND SPACE ADMINISTRATION
LEWIS RESEARCH CENTER
CLEVELAND, OHIO

DWG. NO. CF-136715

ARCH. STRUC. RECORD DWG.
CHANGES TO BE MADE BY AUTHORIZED DRAFTSMEN ONLY