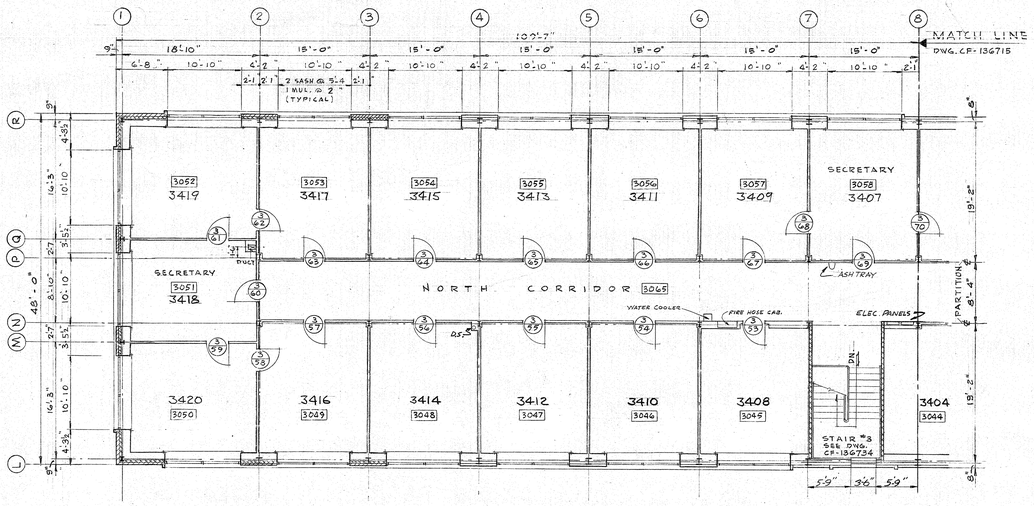

NORTH WEST WING

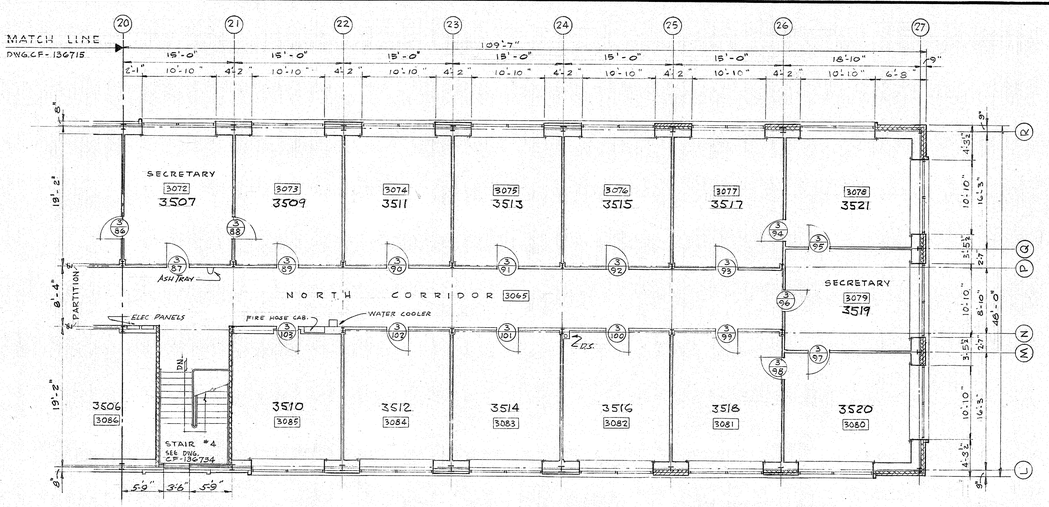

NORTH EAST WING

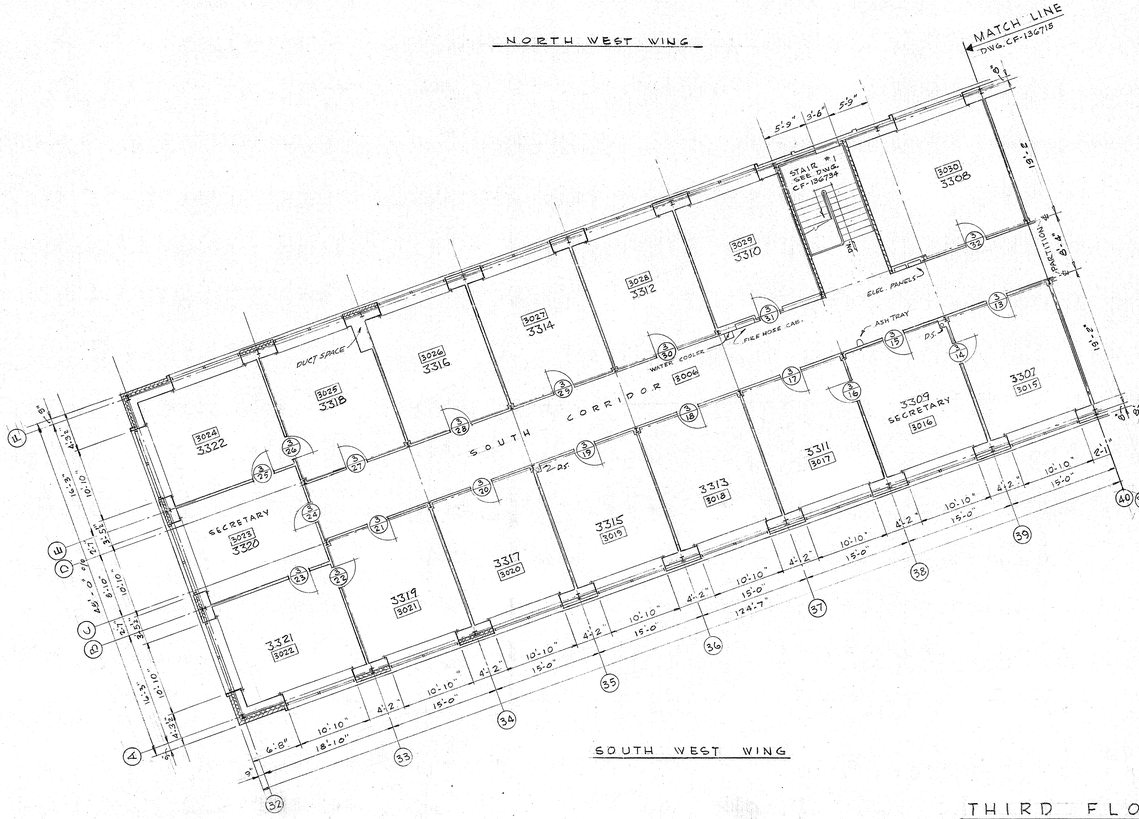

SOUTH WEST WING

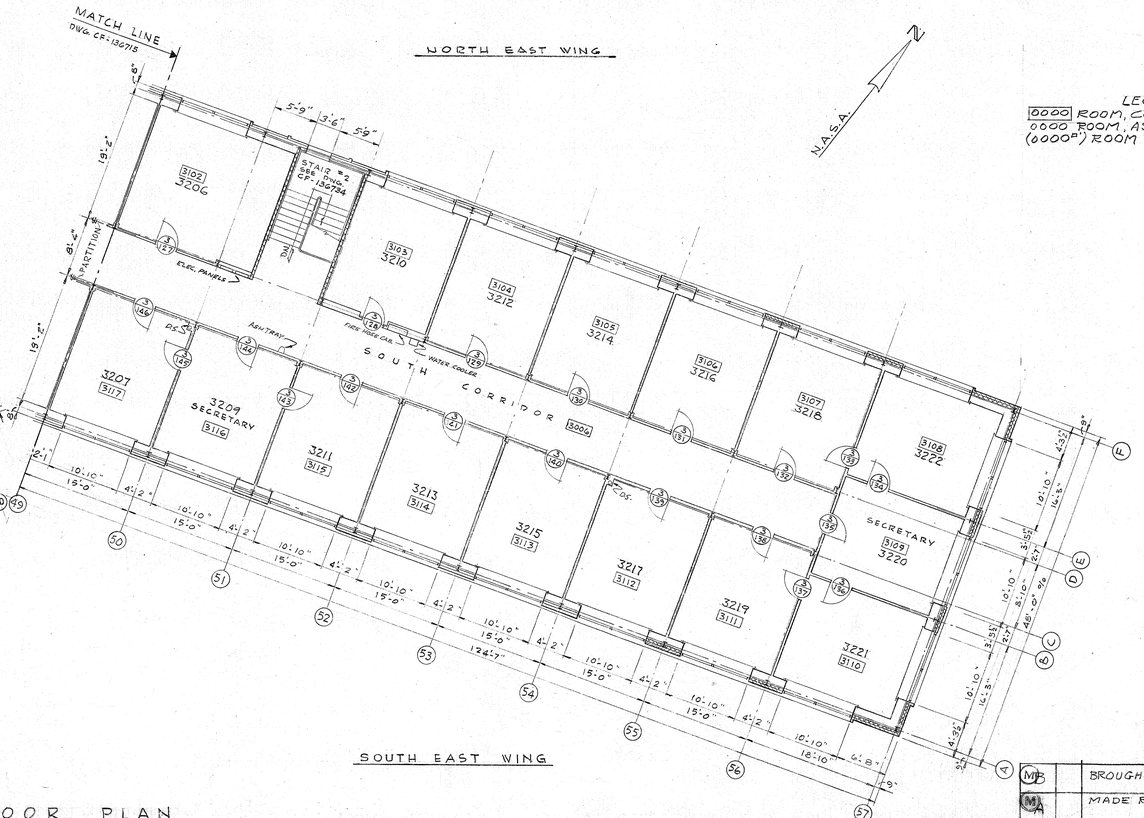

SOUTH EAST WING

NASA

LEGEND
0000 ROOM, CONSTRUCTION NUMBER
0000 ROOM, ASSIGNED NUMBER,
(0000^{SF}) ROOM AREA - SQUARE FEET.

THIRD FLOOR PLAN

SCALE 1/8" = 1'-0"

CHANGE NO.	REVISION (TP)	DATE	CK. APP.
MP5	BROUGHT UP TO DATE	6-21-66	ALH BBB
MP4	MADE RECORD DRAWING	2-11-63	ALH MWJ

DEVELOPMENT ENGINEERING BUILDING PROJECT
STRUCTURES - ROADS - UTILITIES
ARCHITECTURAL
DEVELOPMENT ENGINEERING BUILDING
THIRD FLOOR PLAN WINGS

HUBBELL & BENES and HOFF, INC.
ARCHITECTS & ENGINEERS
1922 E. 107th St. CLEVELAND 6, OHIO

DESIGNED BY— RGDEST & JJK CHECKED BY— J.W.M. APPROVED BY— JJK
DATE 7-30-62 JOB NO. 62303 SHEET ACCOUNT NO. 0110

SCALE 1/8" = 1'-0"
UNLESS OTHERWISE SPECIFIED
.X DIM. MAY VARY ±
.XX DIM. MAY VARY ±
.XXX DIM. MAY VARY ±
ANGULAR DIM. MAY VARY ±
DIM. MAY VARY ±
BREAK SHARP EDGES

REFERENCES		INITIAL	DATE
JO 11806	DR.		
C-3470	CK.		
	D.ENG.	GWK	
	R.ENG.		
	P.ENG.	JJK	
	D.S.HD.	MWJ	
SAFETY APPROVAL	A.&M.HD.	Wm	
BY DATE	D.D.CH.	JJK	8-16-62
AREA SAFETY COMM.	R.D.CH.		

NATIONAL AERONAUTICS AND SPACE ADMINISTRATION
LEWIS RESEARCH CENTER
CLEVELAND, OHIO

DWG. NO. CF-136716

ARCH. STRUC. RECORD DWG.
CHANGES TO BE MADE BY AUTHORIZED DRAFTSMEN ONLY

STATE OF OHIO JOHN G. KISH 954 REGISTERED ARCHITECT