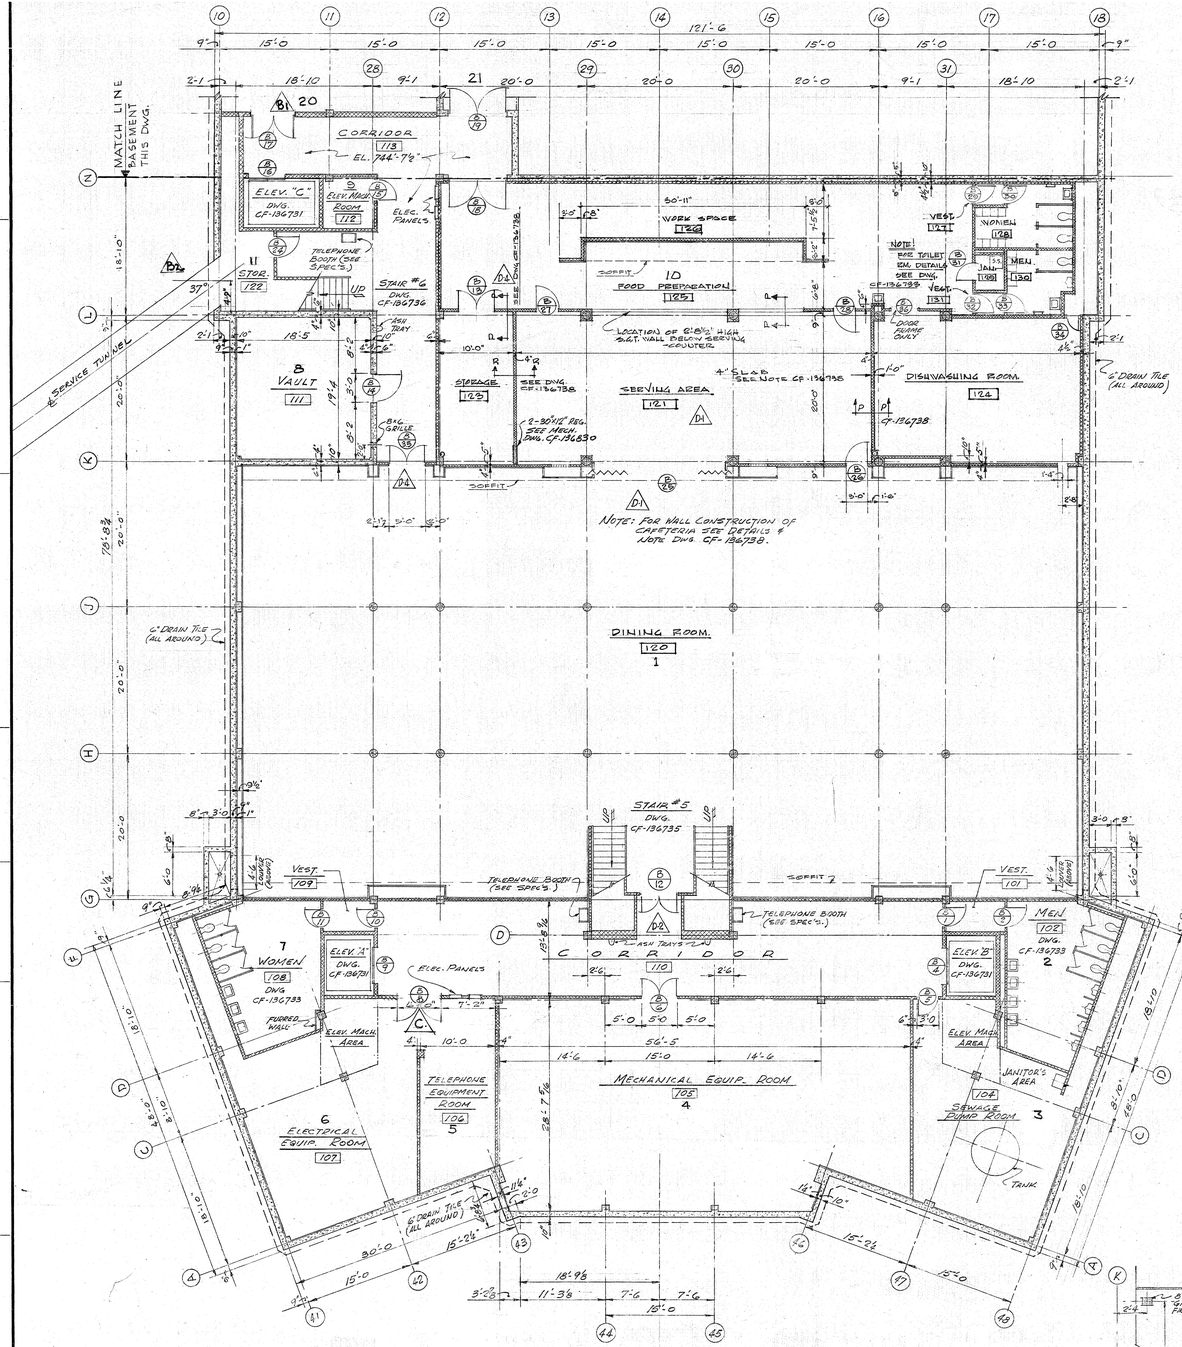

BASEMENT PLAN

SCALE: 1/8" = 1'-0"

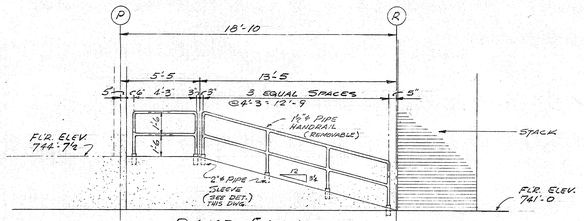

RAMP ELEVATION

SCALE: 1/8" = 1'-0"

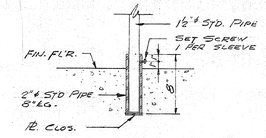

PIPE SLEEVE DET.

SCALE: 1½" = 1'-0"

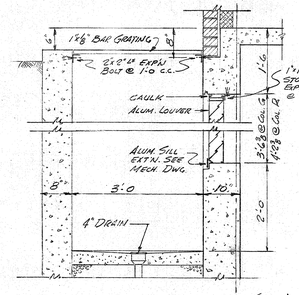

SECTION THRU AREAWAY (TYP.)

SCALE: 3/4" = 1'-0"

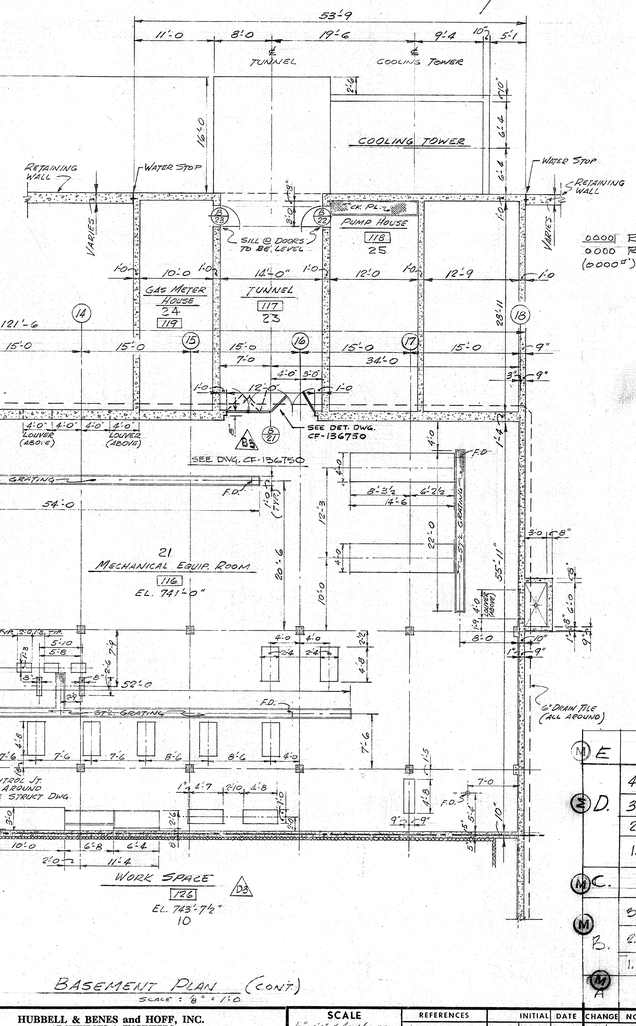

BASEMENT PLAN (CONT)

SCALE: 1/8" = 1'-0"

BASEMENT PLAN

SCALE: 1/8" = 1'-0"

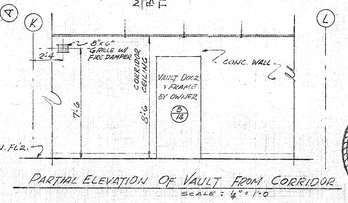

PARTIAL ELEVATION OF VAULT FROM CORRIDOR


LEGEND

0000 ROOM-CONSTRUCTION NUMBER
0000 ROOM-ASSIGNED NUMBER
(0000") ROOM AREA - SQUARE FEET

CHANGE	NO.	REVISION	DATE	CK. APP.
M E		BROUGHT UP TO DATE	6-24-66	ALH
E D.	4.	RELOCATED DOOR B/19 ADDED DOORS B/20 & B/21 IN PLACE OF B/19 LOCATION	11/7/63	
	3.	CHANGED REV. AREA (113 TO 126) TO WORK SPACE AM #126		
	2.	RELOCATED DOOR B/3 & REVISED AREA WHERE DOOR WAS LOCATED		
	1.	REVISED ROOM 120 & 121; ADDED ROOMS 123 TO 130 & COMPLETE CAFETERIA AREA - ADDED NOTE		
M C.		ELIMINATE DOOR B/7, CHANGE B-8 TO PR. DOORS, SHORTEN PART'N	4/1/63	
M B.	3.	DOOR B/21 REVISED	3-13-63	
	2.	TUNNEL INDICATED		
	1.	PARTITION ADDED & DOOR B-17 RELOCATED		
M A		MADE RECORD DRAWING	2-12-63	ALH

HUBBELL & BENES and HOFF, INC.
ARCHITECTS & ENGINEERS
1922 E. 107th St. CLEVELAND 6, OHIO

APPROVED
REV. A. 3/4/63 — 3/8/63
REV. D 10/31/63 — 10/31/63

DESIGNED BY— G.L. CHECKED BY— J.W.M. APPROVED BY— J.G.K.
DATE 7-30-62 JOB NO. 62303 SHEET ACCOUNT NO. 0103

STATE OF OHIO JOHN G. KISH 954 REGISTERED ARCHITECT

SCALE 1/8" = 1'-0" & AS NOTED
UNLESS OTHERWISE SPECIFIED
.X DIM. MAY VARY ±
.XX DIM. MAY VARY ±
.XXX DIM. MAY VARY ±
ANGULAR DIM. MAY VARY ±
___ DIM. MAY VARY ±
BREAK SHARP EDGES

SAFETY APPROVAL BY DATE AREA SAFETY COMM.

REFERENCES	INITIAL	DATE
DR.		
CK.		
D.ENG.		
R.ENG.		
P.ENG.		
D.S.HD.		
S.S-HD.		
D.D.CH.		
R.D.CH.		

DEVELOPMENT ENGINEERING BUILDING PROJECT
STRUCTURES - ROADS - UTILITIES
ARCHITECTURAL
DEVELOPMENT ENGINEERING BUILDING
BASEMENT PLAN - CENTER CORE

NATIONAL AERONAUTICS AND SPACE ADMINISTRATION
LEWIS RESEARCH CENTER
CLEVELAND, OHIO

DWG. NO. CF-136710

ARCH. STRUC. RECORD DWG.
CHANGES TO BE MADE BY ARCH.