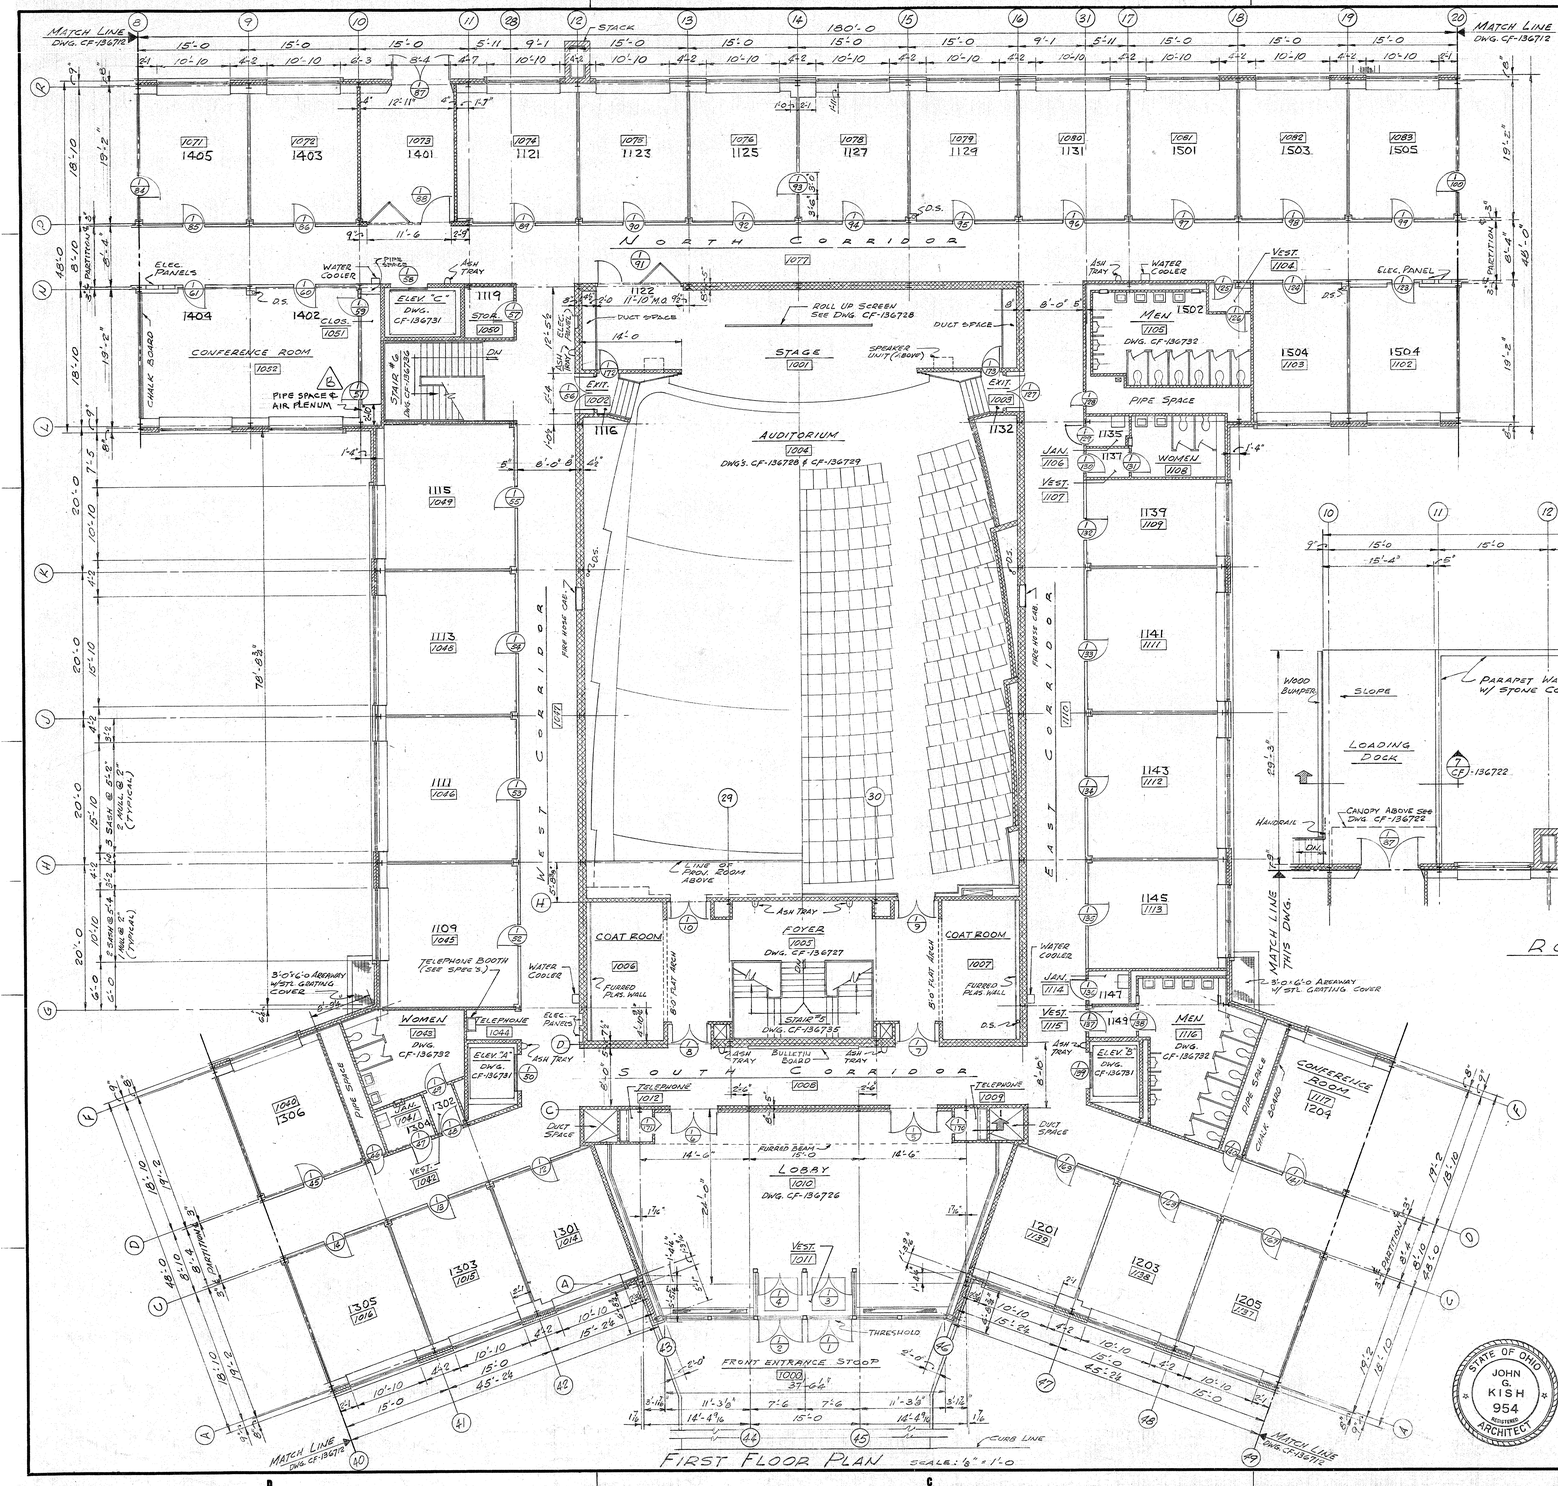

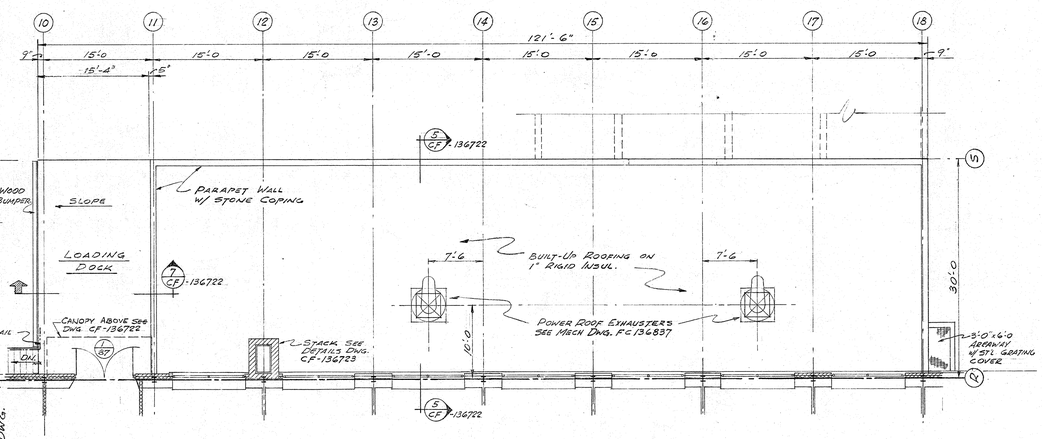

ROOF PLAN @ FIRST FL'R.
SCALE: 1/8" = 1'-0"

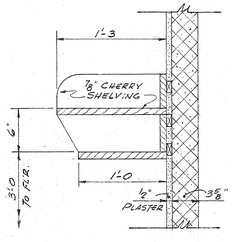

SECTION 1-1 (TYPICAL FOR LOBBY TELEPHONE ROOMS)
SCALE: 1/4" = 1'-0"

LEGEND
0000 ROOM, CONSTRUCTION NUMBER.
0000 ROOM, ASSIGNED NUMBER.
(0000 SQ. FT.) ROOM AREA - SQUARE FEET.

CHANGE NO.	REVISION	DATE	CK. APP.
C	BROUGHT UP TO DATE	6-24-66	ALH
B	DOOR 1-B1 RELOCATED, PIPE SPACE & PLENUM ENLARGED	1-13-63	ALH
A	MADE RECORD DRAWING	2-12-63	ALH

DEVELOPMENT ENGINEERING BUILDING PROJECT
STRUCTURES - ROADS - UTILITIES
ARCHITECTURAL
DEVELOPMENT ENGINEERING BUILDING
FIRST FLOOR PLAN CENTER CORE

NATIONAL AERONAUTICS AND SPACE ADMINISTRATION
LEWIS RESEARCH CENTER
CLEVELAND, OHIO

DWG. NO. CF-136711

HUBBELL & BENES and HOFF, INC.
ARCHITECTS & ENGINEERS
1922 E. 107th St. CLEVELAND 6, OHIO

APPROVED
REV. B. 2-4-63 [illegible] 2/13/63

DESIGNED BY— E.L. CHECKED BY— J.W.H. APPROVED BY— [illegible]
DATE 7-30-62 JOB NO. 62303 SHEET ACCOUNT NO. 0102

SCALE 1/8" = 1'-0"
UNLESS OTHERWISE SPECIFIED
.X DIM. MAY VARY ±
.XX DIM. MAY VARY ±
.XXX DIM. MAY VARY ±
ANGULAR DIM. MAY VARY ±
.....DIM. MAY VARY ±
BREAK SHARP EDGES

REFERENCES		INITIAL	DATE
JO 11809	DR.		
C-5470	CK.		
	D.ENG.	E.L.	
	R.ENG.		
	P.ENG.	T.H.	
	D.S.HD.	J.W.H.	
SAFETY APPROVAL	R.S.HD.	J.W.H.	
BY DATE	D.D.CH.	E.L.	7-26-62
AREA SAFETY COMM.	R.D.CH.		

STATE OF OHIO JOHN G. KISH 954 REGISTERED ARCHITECT

ARCH. STRUC. RECORD DWG
CHANGES TO BE MADE BY AUTH.