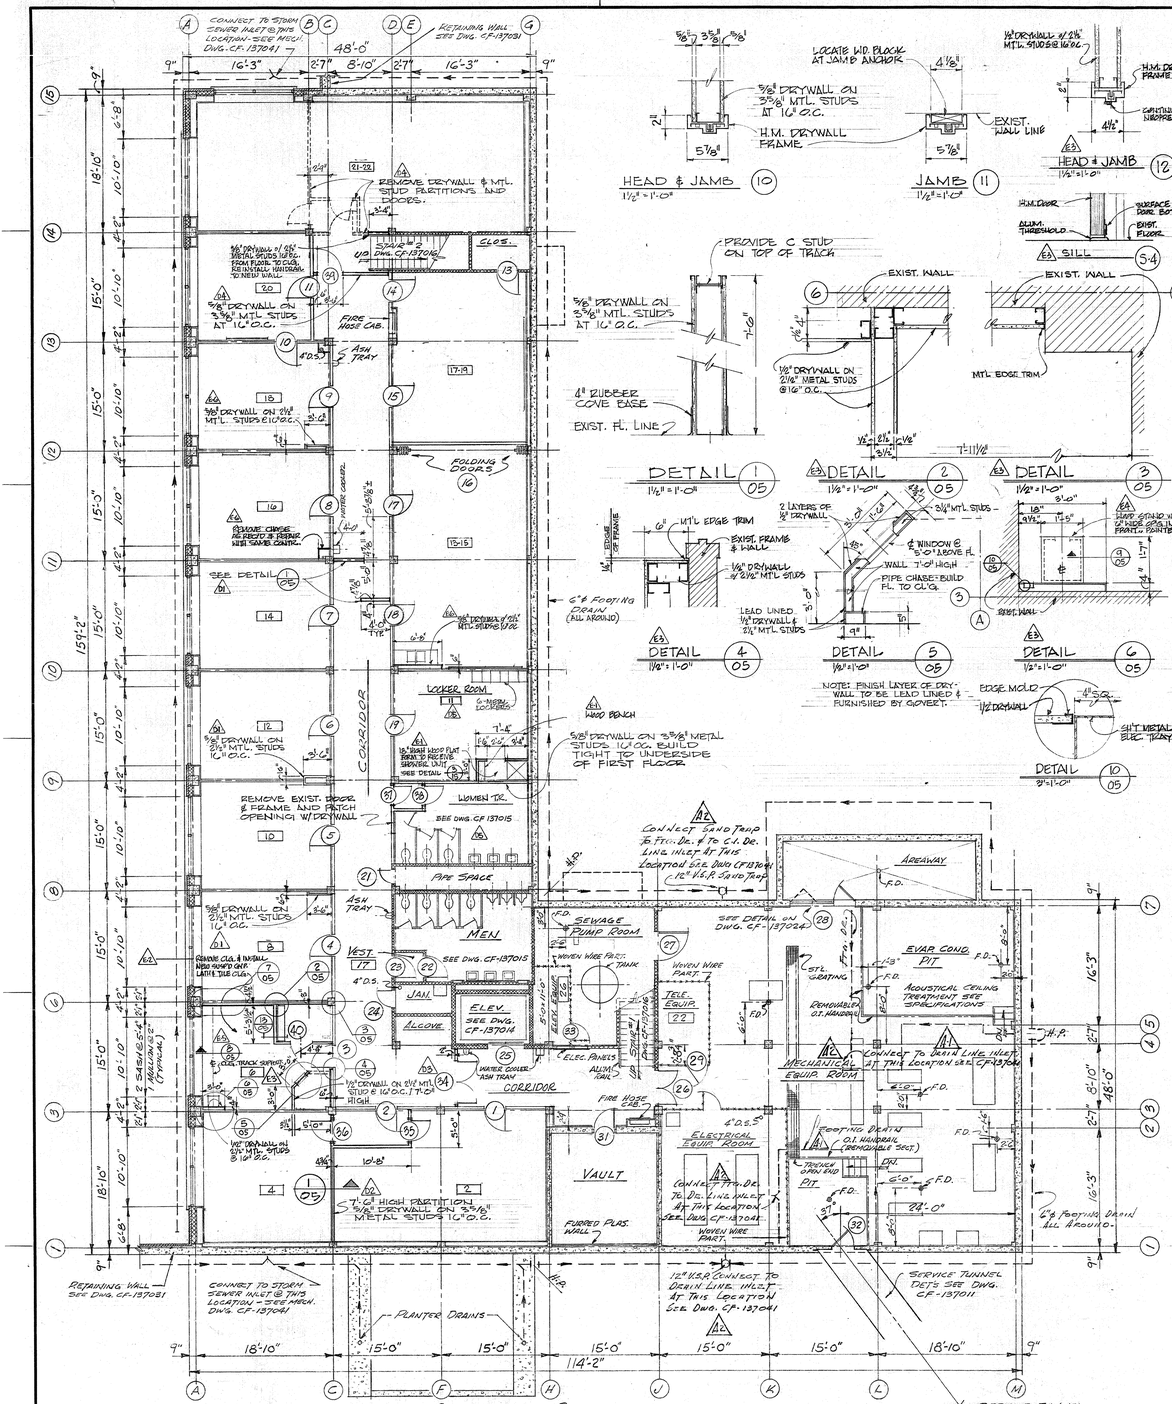

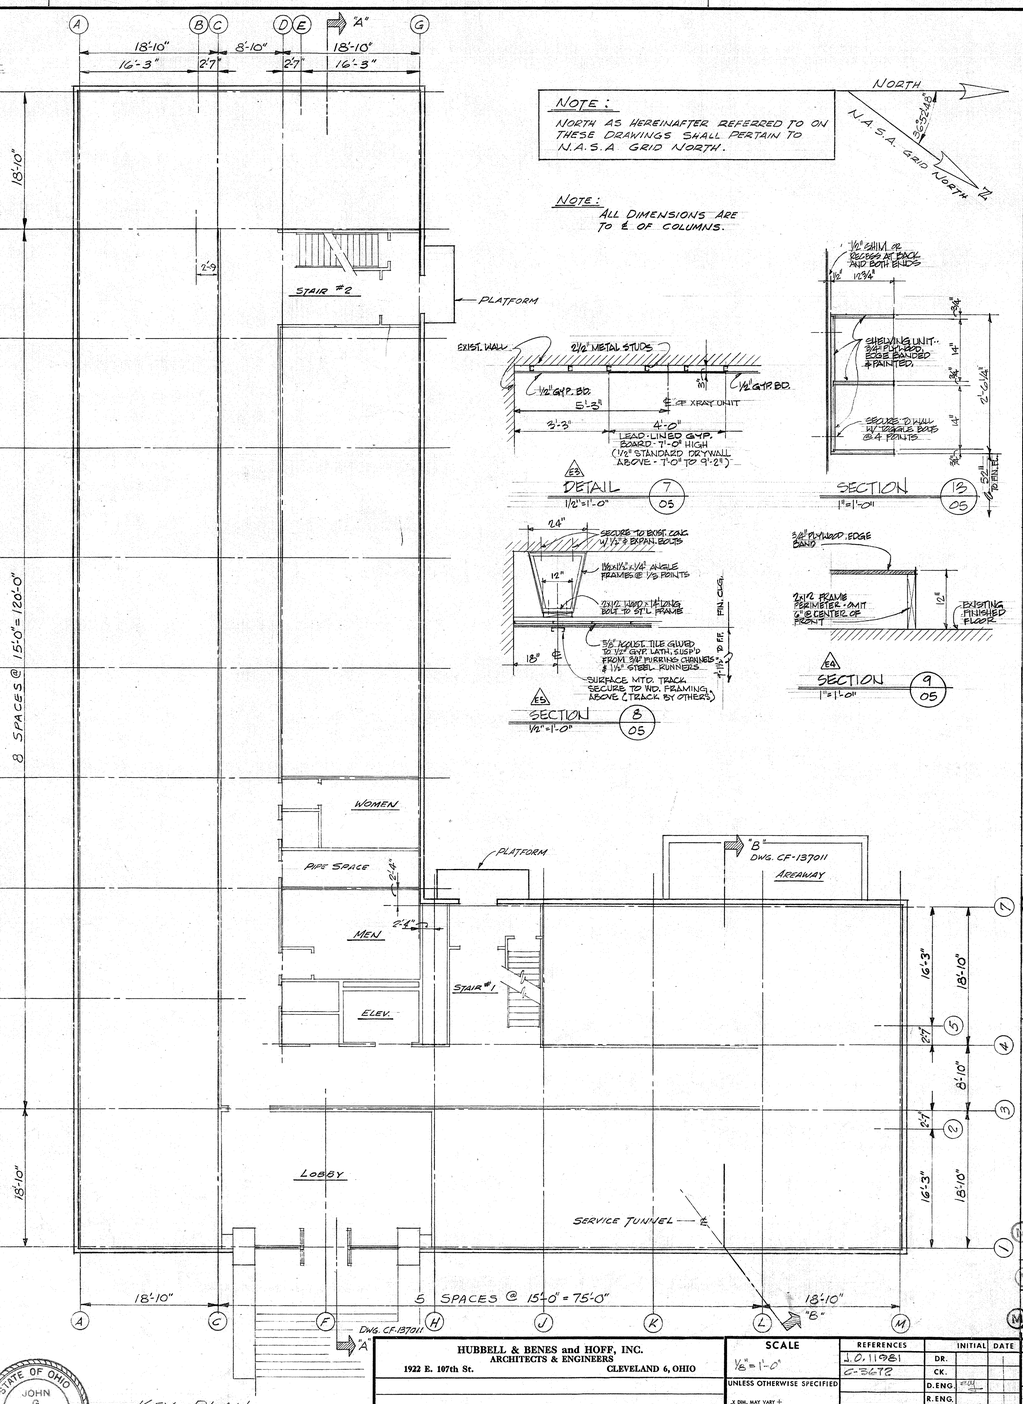

ARCHITECTURAL SYMBOLS

- EARTH
- FILL
- CONCRETE
- CEMENT & PLASTER
- CONCRETE BLOCK
- TERRAZZO
- GLASS
- BRICK
- STRUCTURAL TILE
- FINISH TILE
- STEEL (LARGE SCALE)
- STEEL (SMALL SCALE)
- METAL (ELEVATION)
- STONE
- WOOD (ROUGH)
- WOOD (FINISHED)
- PLYWOOD
- INSULATION

	6	CONSTRUCT CHASE. ROOM #13 & 15 & REPAIR CHASE. ROOM #16	5-18-77	R.S.
M	5	ADD NEW CEILING TRACK SUPPORT & DETAIL - ROOM #6		
	4	ADD NEW PAINTED WOOD PLATFORM & DETAIL - ROOM #6		
E.	3	ADD NEW PARTITIONS, DOOR, WINDOW AND FURRED WALLS - ROOM #6		
	2	REMOVE EXIST. CEILING & INSTALL NEW SUSP'D CLG. - ROOM #6		
	1	MODIFICATIONS TO EXISTING SHOWER - ROOM #11		
	6	UPDATE ROOM NUMBERS	9-23-76	R.S.
	5.	REMOVE DOOR #20 - ADD NEW WOMEN'S TOILET ROOM & LOCKER ROOM W/ SHOWER UNIT.		
D.	4.	DEMOLITION OF PARTITIONS IN ROOM #10 & DOOR #12 - ADD CORRIDOR PARTITION AND DOOR #9A		
	3.	ADD CORRIDOR PARTITION & DOOR #9A		
	2.	ADD PARTITIONS IN ROOM #2/A & DOORS #5 & #6		
	1.	ADD MISC. PARTITIONS AND CHASES IN CORRIDOR & ROOMS #8, #10 & #12		
M C		BROUGHT UP TO DATE	6-7-67	ALH
M B		BROUGHT UP TO DATE. MADE RECORD DWG.	6-3-66	ALH
	2.	ADD NEW DRAIN LINE INLETS		
M A.	1.	ROOFING DR. TILE ADDED	8/7/63	

CHANGE NO.	REVISION	DATE	CK. APP.

HUBBELL & BENES and HOFF, INC.
ARCHITECTS & ENGINEERS
1922 E. 107th St. CLEVELAND 6, OHIO

DESIGNED BY— E.F.L. CHECKED BY— J.W.M. APPROVED BY— JAK
DATE 5-18-63 JOB NO. 63317 SHEET ACCOUNT NO. 0103

SCALE 1/8" = 1'-0"
UNLESS OTHERWISE SPECIFIED
.X DIM. MAY VARY ±
.XX DIM. MAY VARY ±
.XXX DIM. MAY VARY ±
ANGULAR DIM. MAY VARY ±
DIM. MAY VARY ±
BREAK SHARP EDGES

REFERENCES: J.O. 11981; C-3672

	INITIAL	DATE
DR.		
CK.		
D.ENG.		
R.ENG.		
P.ENG.		
D.S.HD.		
D.D.CH.		5-20-63
R.D.CH.		

SAFETY APPROVAL BY DATE
AREA___SAFETY COMM.

DEVELOPMENT ENGINEERING BUILDING ANNEX BLDG. 501
ARCHITECTURAL BASEMENT AND KEY PLANS

NATIONAL AERONAUTICS AND SPACE ADMINISTRATION
LEWIS RESEARCH CENTER
CLEVELAND, OHIO

DWG. NO. CF-137005

STATE OF OHIO JOHN G. KISH 954 REGISTERED ARCHITECT

A. STRUC. RECORD
(NOT TO BE MADE BY APPRENTICED DRAFTSMEN)