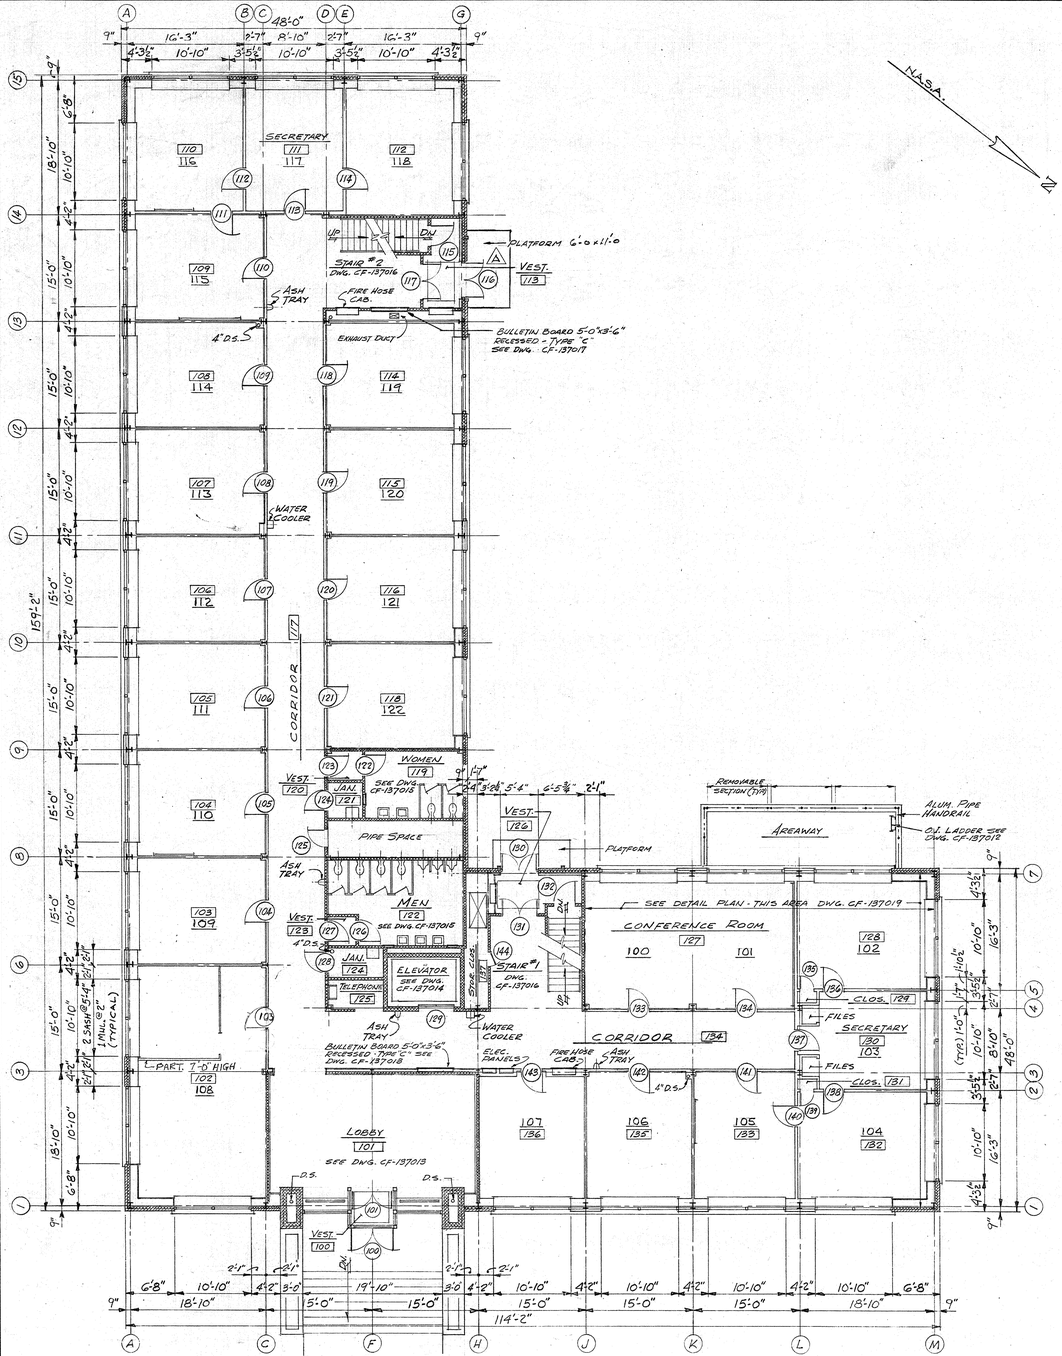

FIRST FLOOR PLAN

SCALE: 1/8" = 1'-0"

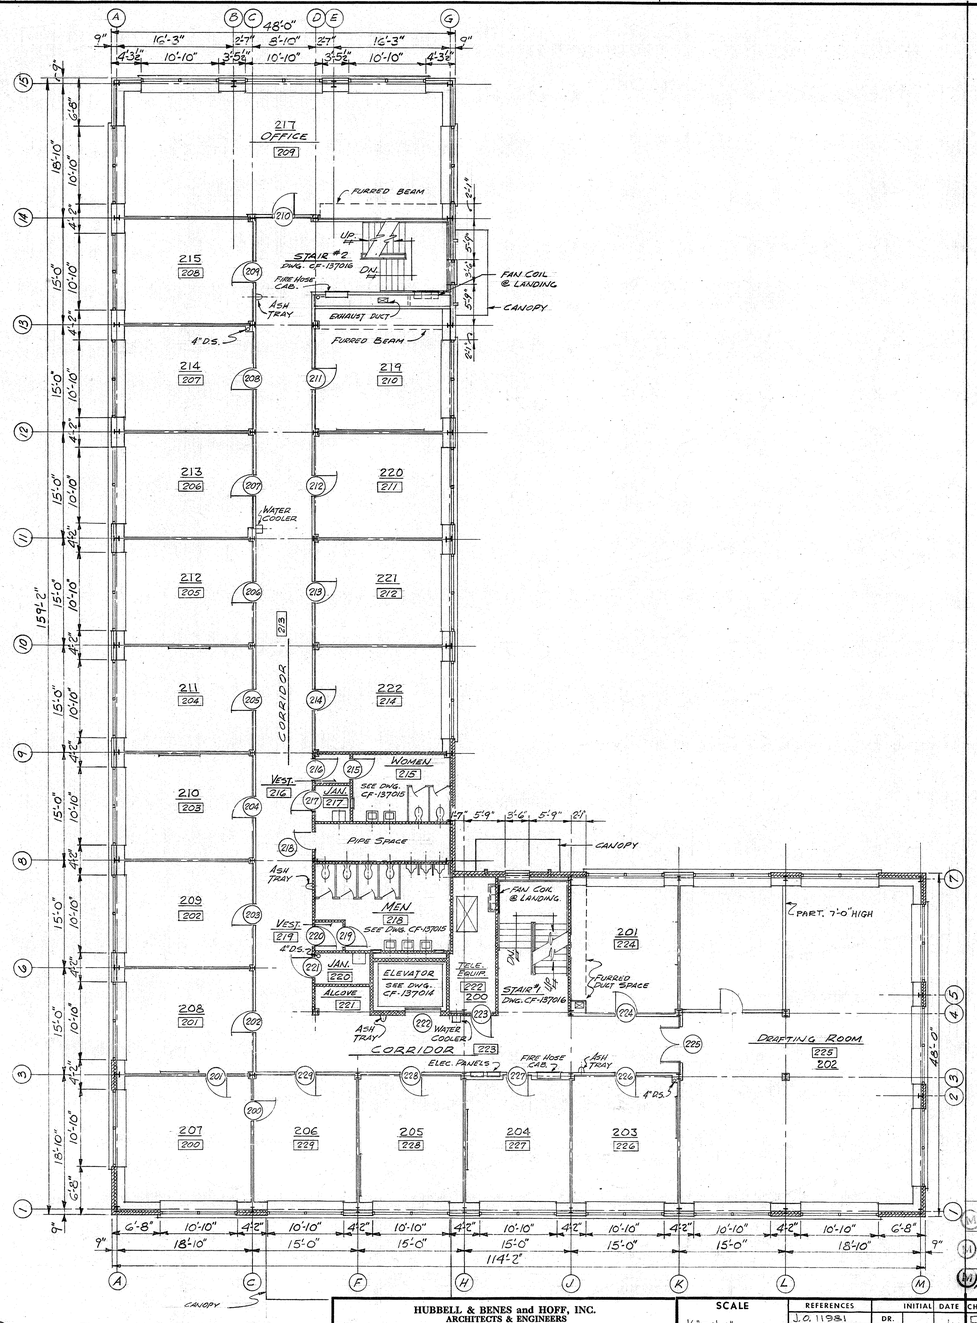

SECOND FLOOR PLAN

SCALE: 1/8" = 1'-0"

STATE OF OHIO JOHN G. KISH 954 REGISTERED ARCHITECT

C	BROUGHT UP TO DATE	6-7-67 ALH
B	BROUGHT UP TO DATE MADE RECORD DWG.	6-8-66 ALH
A	TO AGREE WITH ADDENDUM NO. 3. DATED 7-30-65	11/3/65

HUBBELL & BENES and HOFF, INC.
ARCHITECTS & ENGINEERS
1922 E. 107th St. CLEVELAND 6, OHIO

DESIGNED BY— E.F.L. CHECKED BY— J.W.M. APPROVED BY— J.G.K.
DATE 5-18-63 JOB NO. 63317 SHEET ACCOUNT NO. 0104

SCALE 1/8" = 1'-0"
UNLESS OTHERWISE SPECIFIED
.X DIM. MAY VARY ±
.XX DIM. MAY VARY ±
.XXX DIM. MAY VARY ±
ANGULAR DIM. MAY VARY ±
DIM. MAY VARY ±
BREAK SHARP EDGES

REFERENCES	INITIAL	DATE
J.O. 11981	DR.	
C-3672	CK.	
	D.ENG.	
	R.ENG.	
	P.ENG.	
	D.S.HD.	
SAFETY APPROVAL	D.D.CH.	5-20-63
BY DATE	R.D.CH.	
AREA SAFETY COMM.		

CHANGE NO.	REVISION	DATE	CK. APP.
(M)			

DEVELOPMENT ENGINEERING BUILDING ANNEX BLDG. 501

ARCHITECTURAL
FIRST & SECOND FLOOR PLANS

NATIONAL AERONAUTICS AND SPACE ADMINISTRATION
LEWIS RESEARCH CENTER
CLEVELAND, OHIO

DWG. NO. CF-137006

ARCH. STRUC. RECORD DWG
CHANGES TO BE MADE BY AUTHORIZED DRAFTSMAN ONLY