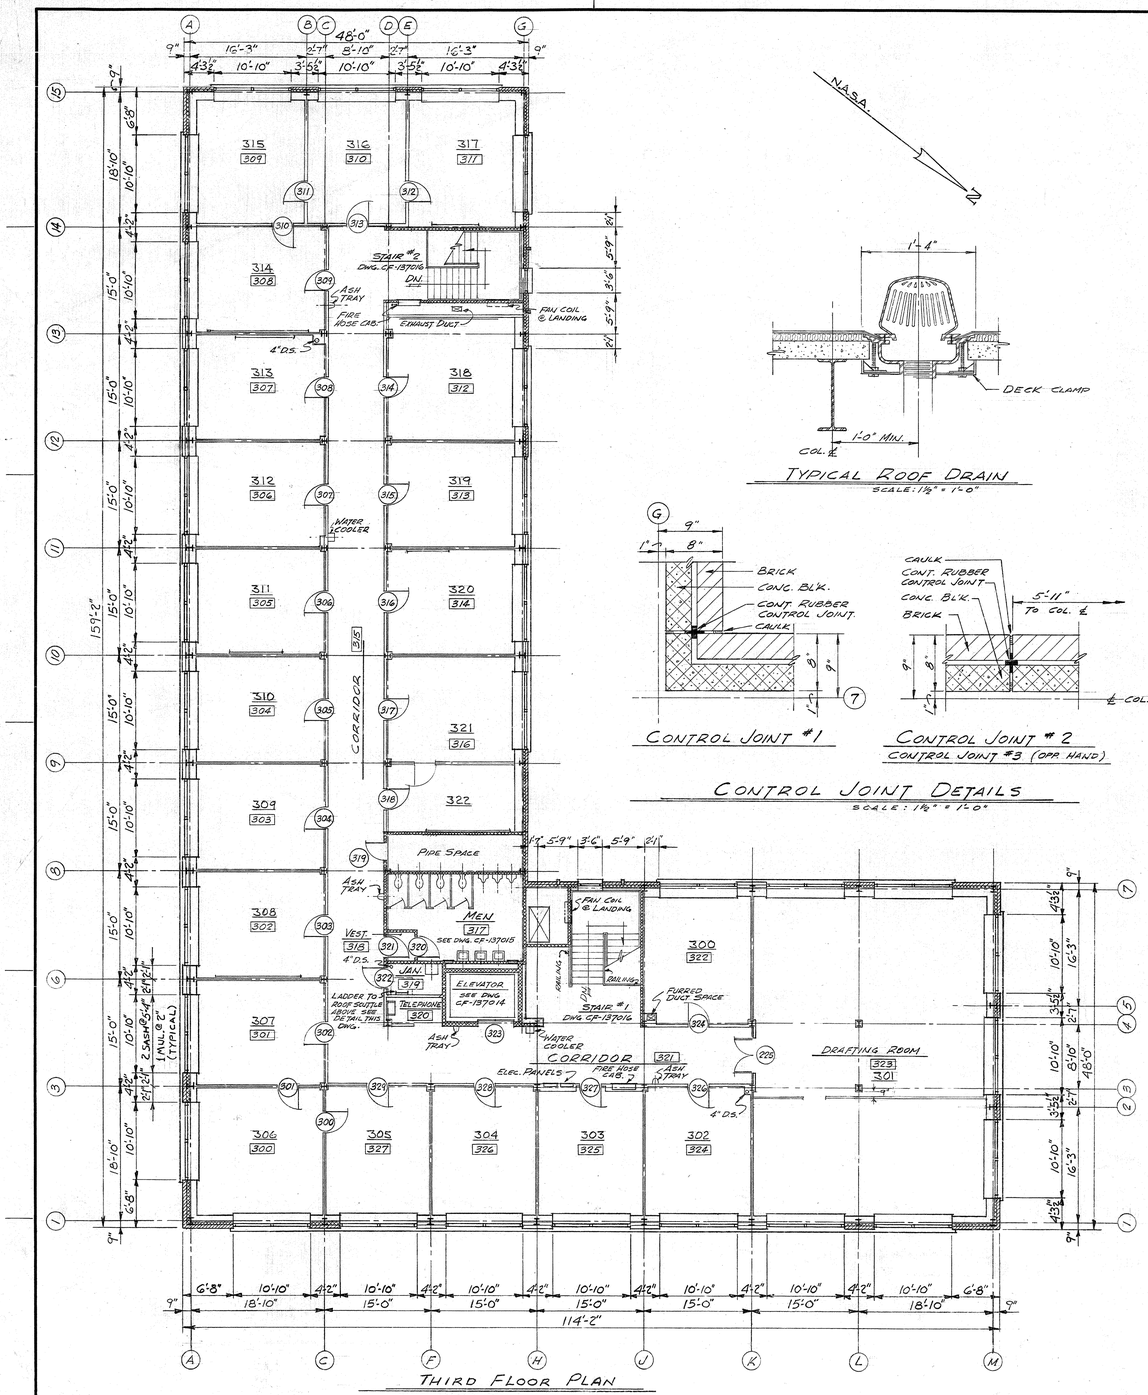

THIRD FLOOR PLAN

SCALE: 1/8" = 1'-0"

TYPICAL ROOF DRAIN

SCALE: 1½" = 1'-0"

CONTROL JOINT #1

CONTROL JOINT # 2

CONTROL JOINT #3 (OPP. HAND)

CONTROL JOINT DETAILS

SCALE: 1½" = 1'-0"

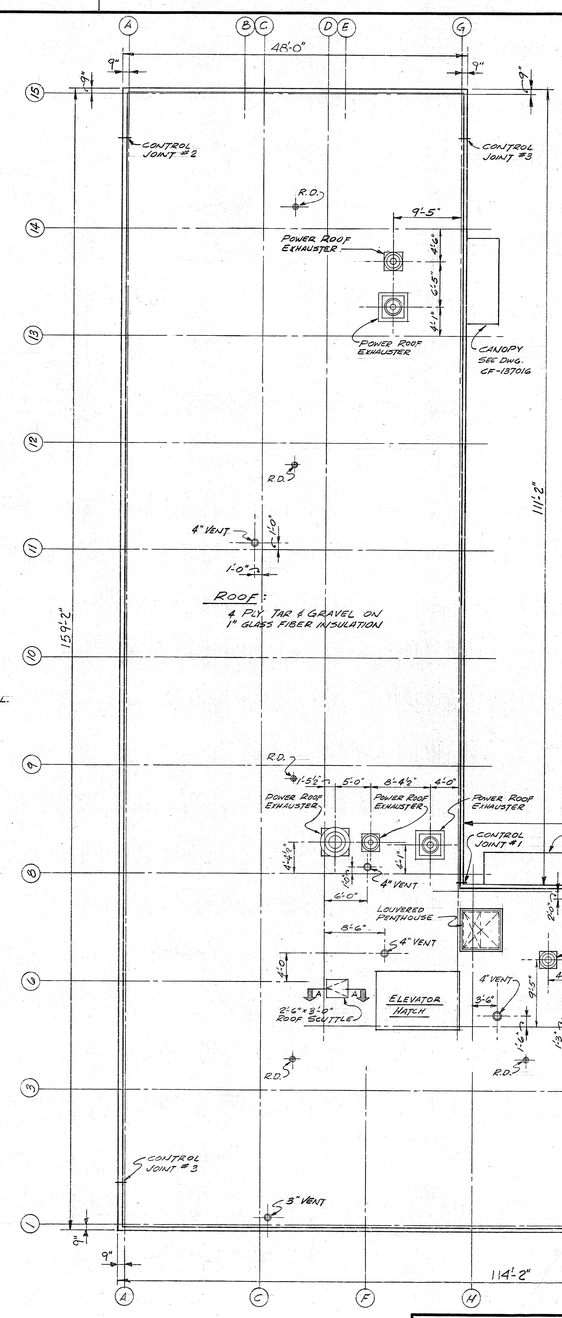

ROOF PLAN

SCALE: 1/8" = 1'-0"

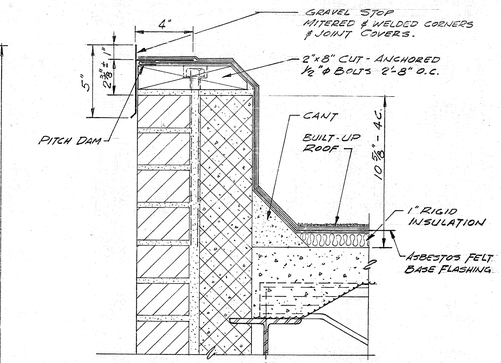

TYPICAL PARAPET & ALUM. COPING DETAIL

SCALE: 3" = 1'-0"

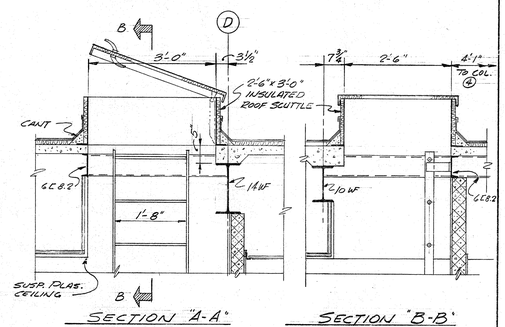

SECTION "A-A"

SECTION "B-B"

ROOF SCUTTLE DETAIL

SCALE: 3/4" = 1'-0"

CHANGE NO.	REVISION	DATE	CK. APP.
(M) B	BROUGHT UP TO DATE	6-7-67	ALH
(M) A	BROUGHT UP TO DATE MADE RECORD DWG.	6-3-66	ALH

HUBBELL & BENES and HOFF, INC.
ARCHITECTS & ENGINEERS
1922 E. 107th St. CLEVELAND 6, OHIO

STATE OF OHIO — JOHN G. KISH 954 REGISTERED ARCHITECT

DESIGNED BY— E.F.L.	CHECKED BY— J.W.M.
APPROVED BY—	
DATE 5-18-63	JOB NO. 63317
SHEET ACCOUNT NO. 0105	

SCALE: AS NOTED
UNLESS OTHERWISE SPECIFIED
.X DIM. MAY VARY ±
.XX DIM. MAY VARY ±
.XXX DIM. MAY VARY ±
ANGULAR DIM. MAY VARY ±
___ DIM. MAY VARY ±
BREAK SHARP EDGES

REFERENCES: J.O. 11981; C-3672

SAFETY APPROVAL — BY DATE — AREA SAFETY COMM.

	INITIAL	DATE
DR.		
CK.		
D.ENG.		
R.ENG.		
P.ENG.		
D.S.HD.		
~~R.ENG.~~		
D.D.CH.		5-20-63
R.D.CH.		

DEVELOPMENT ENGINEERING BUILDING ANNEX — BLDG. 501

ARCHITECTURAL — THIRD FLOOR & ROOF PLANS & DETAILS

NATIONAL AERONAUTICS AND SPACE ADMINISTRATION
LEWIS RESEARCH CENTER
CLEVELAND, OHIO

DWG. NO. CF-137007

ARCH. STRUC. RECORD DWG.
CHANGES TO BE MADE BY AUTHORIZED DRAFTSMEN ONLY