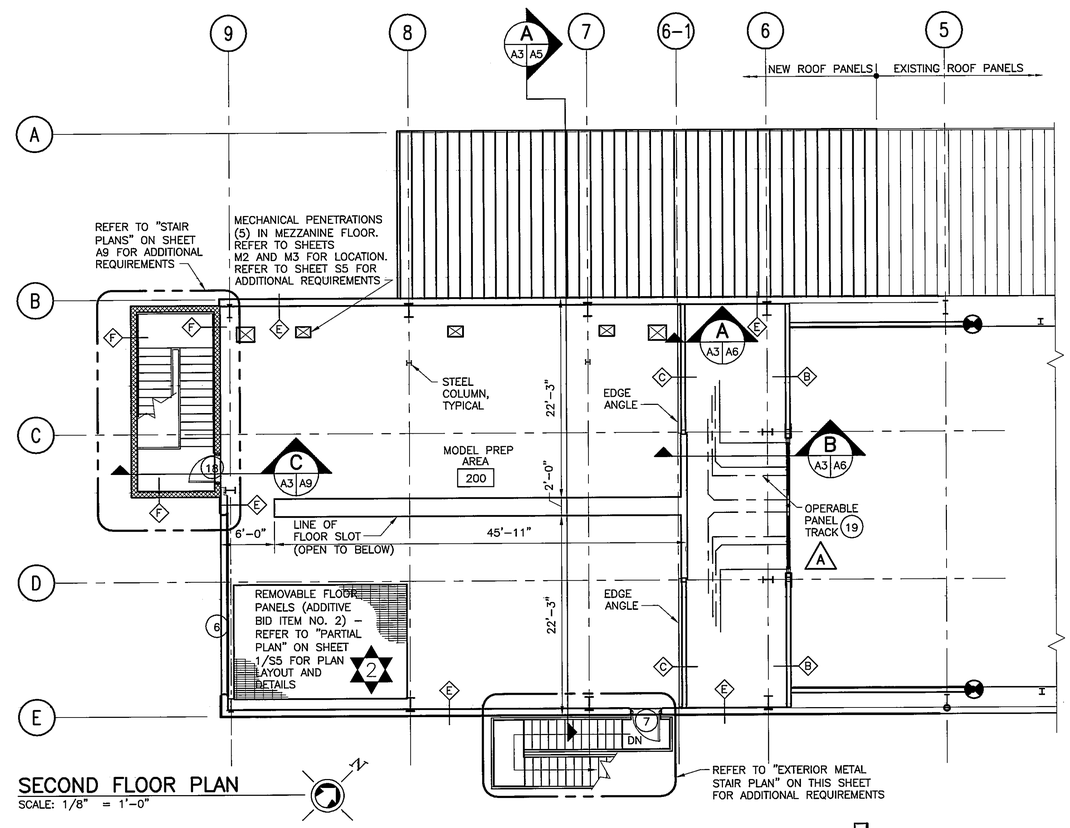

SECOND FLOOR PLAN

SCALE: 1/8" = 1'-0"

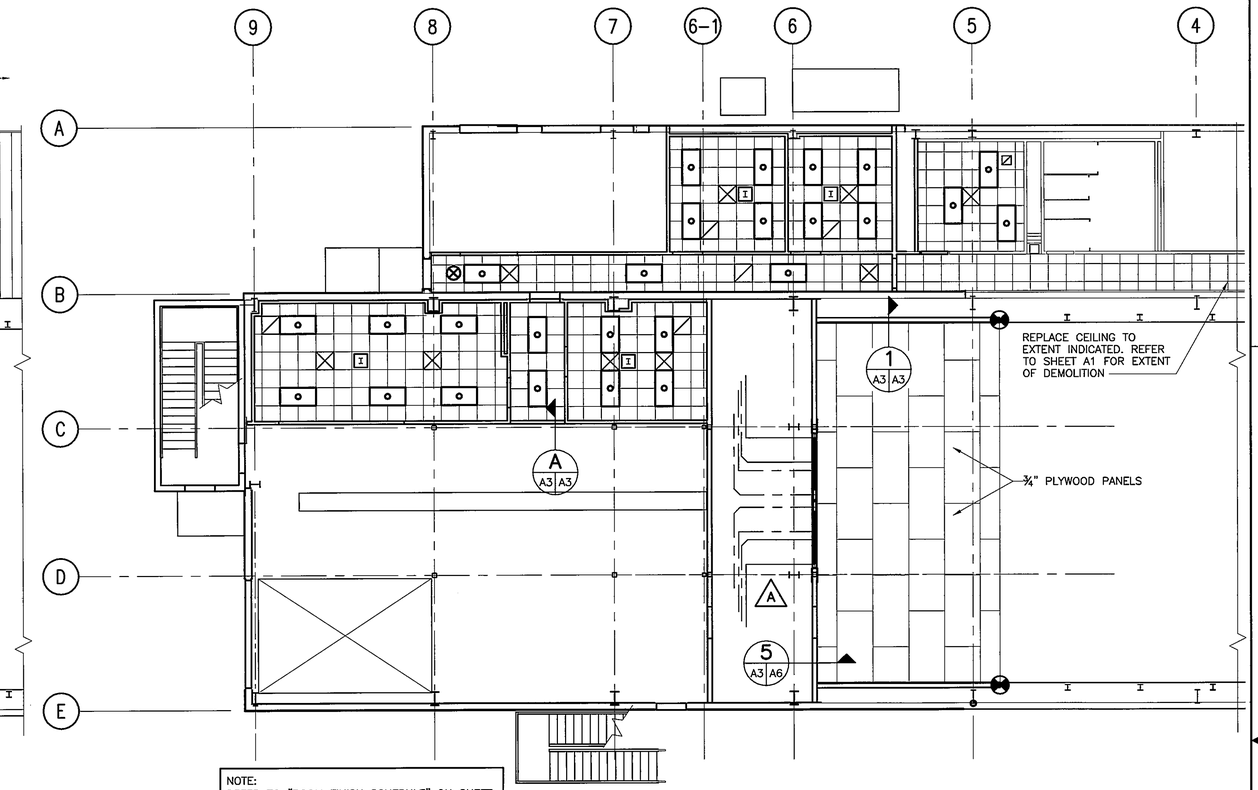

NOTE:
REFER TO "ROOM FINISH SCHEDULE" ON SHEET A7 FOR CEILING HEIGHTS.

FIRST FLOOR REFLECTED CEILING PLAN

SCALE: 1/8" = 1'-0"

LEGEND

- 2' x 2' ACOUSTIC CEILING AND GRID
- EXHAUST AIR REGISTER
- SUPPLY AIR GRILLE
- RETURN AIR GRILLE
- IONIZATION DETECTOR
- EXIT LIGHT
- 2' x 4' FLUORESCENT LIGHT FIXTURE
- 1' x 4' FLUORESCENT LIGHT FIXTURE

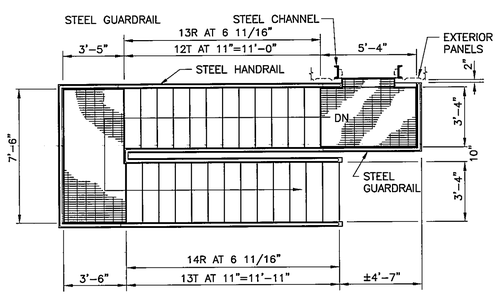

NOTE:
REFER TO STRUCTURAL DRAWING SHEET S9 FOR PARTIAL FRAMING PLANS, DETAILS AND ADDITIONAL REQUIREMENTS AND INFORMATION

EXTERIOR METAL STAIR PLAN

SCALE: 1/4" = 1'-0"

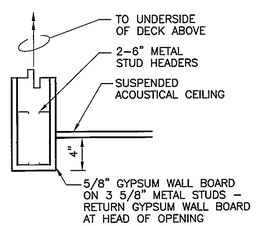

TYPICAL BULKHEAD CEILING DETAIL

SCALE: 1 1/2" = 1'-0"

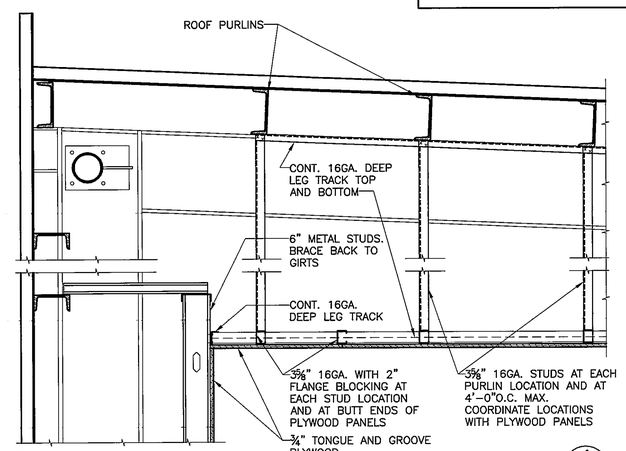

DETAIL

SCALE 3/4" = 1'-0"

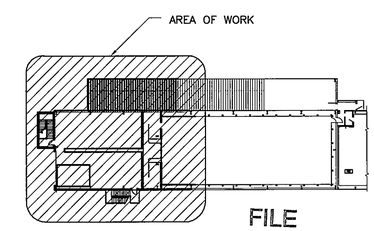

KEY PLAN

FILE
MAY 18 2005

REVISIONS													
DATE	LTR	FREQ	DESCRIPTION	BY	CHECK	APPD	DATE	LTR	FREQ	DESCRIPTION	BY	CHECK	APPD
3/7/05	A	2	RECORD SET										

Sverdrup
TECHNOLOGY INC.
TECHNOLOGY GROUP

WORK ORDER NO. CD97600A03/1118

APPROVALS	DATE
DRAFT. J. CLINE	08/21/02
ENG./DES. J. CLINE	08/21/02
CHECK G. WILLIS	08/21/02
PROJ. ENG. W. RASH	08/21/02
SUPV'N. R. WINEMAN	08/21/02

APPROVALS				
NAME	ORGANIZATION	DATE		DATE
M.D.MASTALER	RSEB	08/23/02	DRAWN	
D.M.SMITH	OSMA	09/03/02	DESIGNED	
R.KERNS	SPE	09/06/02	CHECKED	
			APPROVED	
			TECH. PROJ. ENG. JKC	08/23/02
			RES. PROJ. ENG. EV	08/23/02

TOLERANCE ON DIMENSIONS UNLESS SHOWN OTHERWISE: ANGULAR ± ; X.XX (2 DECIMAL PLACES) ±.02 ; X.XXX (3 DECIMAL PLACES) ±.005

SURFACE FINISH IN MICROINCHES RMS UNLESS SHOWN OTHERWISE √

FOR DRAWING INDEX SEE DRAWING 1239593

NATIONAL AERONAUTICS & SPACE ADMINISTRATION
LANGLEY RESEARCH CENTER
HAMPTON, VIRGINIA 23681-2199

PROJECT TITLE: CONSTRUCTION OF MODEL PREP/ STORAGE & DATA PROCESSING ROOM

DRAWING TITLE: SECOND FLOOR PLAN, FIRST FLOOR REFLECTED CEILING PLAN

BUILDING NO. 1299F | SIZE D | DRAWING NO. 1239599 | LATEST REV. A

SHEET NO. A3

NNL13461322Q
Attachment 6