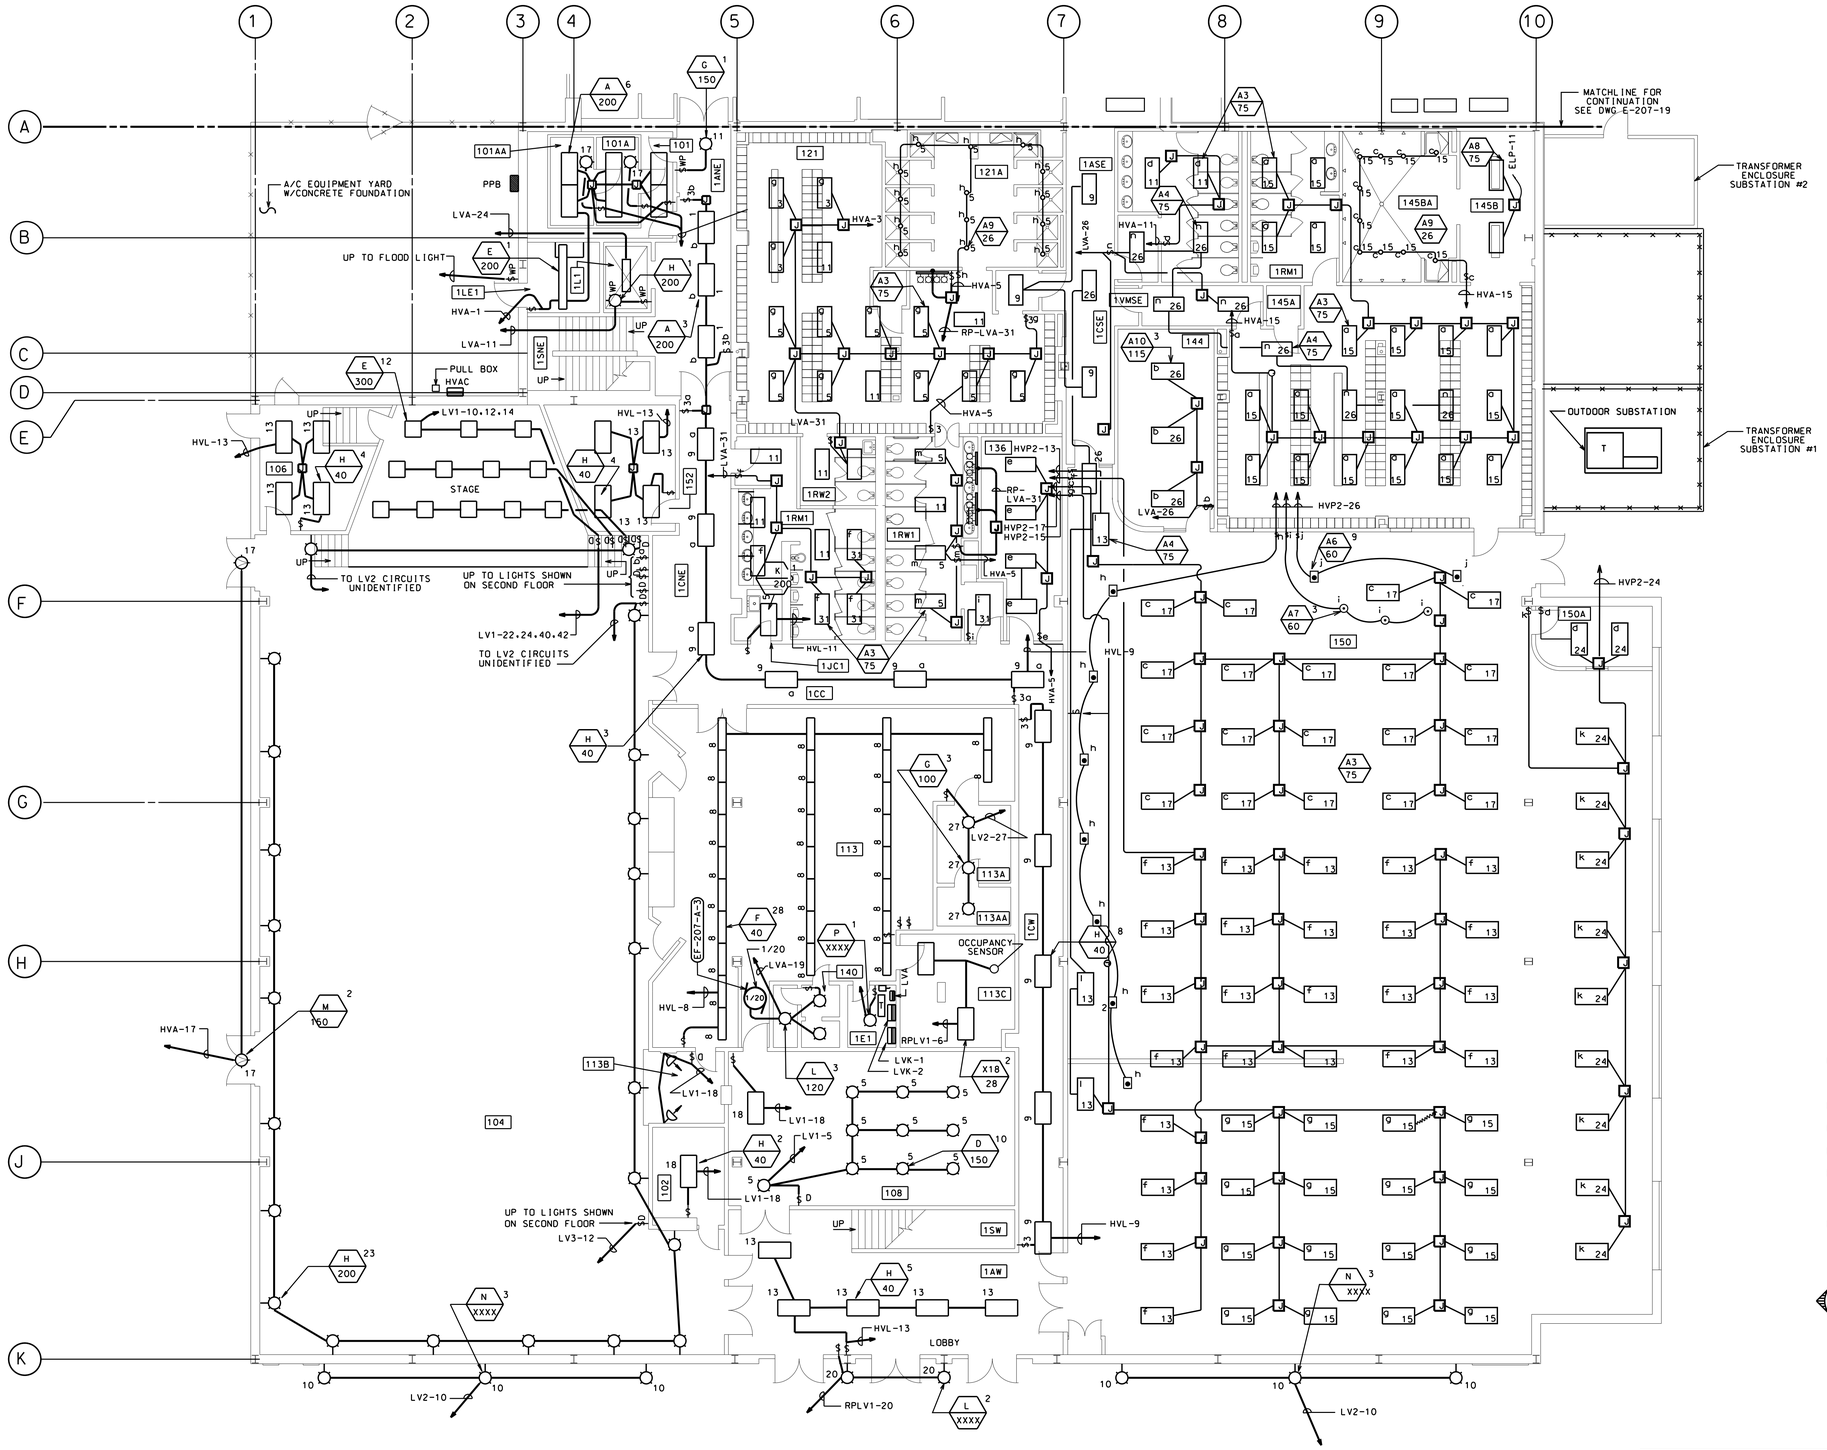

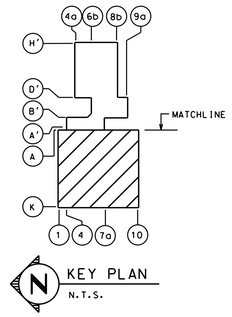

FIRST FLOOR-LIGHTING PLAN

SCALE: 1/8"=1'-0"

PORTE COCERE

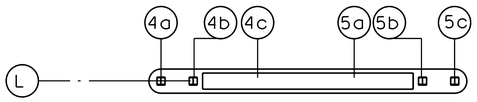

NOTES:

1) D=DIMMERS-HUNT MODEL A-2000.
2) FOR LIGHTING FIXTURE SCHEDULES SEE DWG E-207-5.

1/8"=1'-0" 4' 0 4' 8' 12' 16' 20'

GRAPHIC SCALE

CAD FILE NAME: E207Z8.DGN

REVISION	DATE	DESCRIPTION
AS-BUILT	06-17-13	DYN190533(AM) COF02106PAG) W46708(GJB) W47721(GJB) W49098(SR)

SIGNATURES		DATE
DR. ALEX	ENG REDRAWN	01-05-04
CH GJB	APPR GJB	01-05-04
GLENN J. BUNCH		01-05-04
REV		
DISCP		
PE		
APPR CHESTER BENNETT		01-06-04

NATIONAL AERONAUTICS & SPACE ADMINISTRATION
LYNDON B. JOHNSON SPACE CENTER HOUSTON, TEXAS

BUILDING 207

FIRST FLOOR-LIGHTING PLAN
WEST WING

PROJECT NO. | SHEET NO. ___ OF ___
PROJECT IDENT. | DWG NO. E-207-8
CODE IDENT. NO. 21358 | SIZE F

6/17/2013 5:16:40 PM User: snyyes1 E207Z8.DGN R:\BLDGS\BLDG207\ELEC\ASBLT\E207Z8.DGN