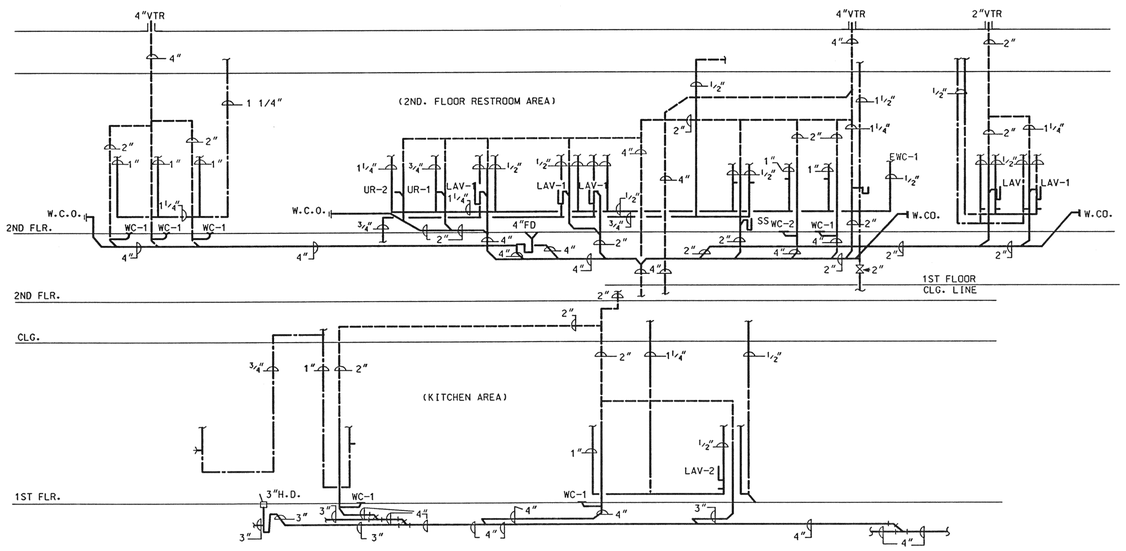

1 PLUMBING RISER DIAGRAM
N.T.S.

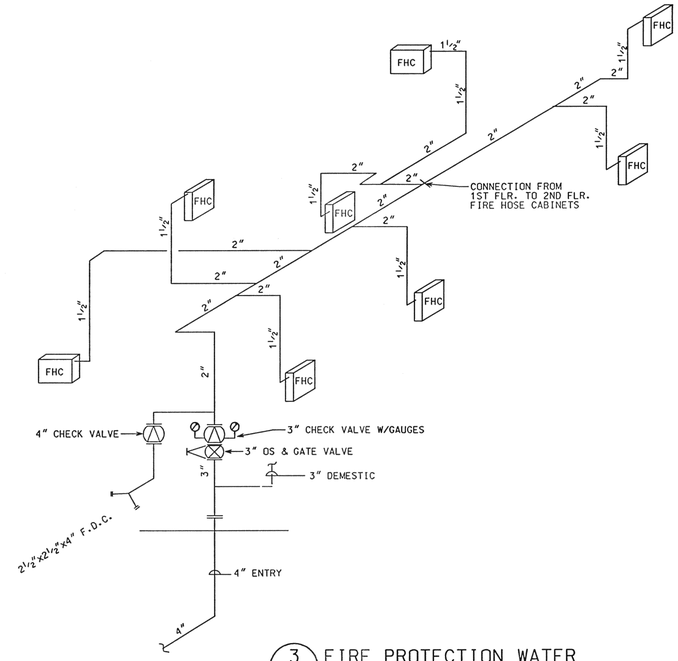

3 FIRE PROTECTION WATER
N.T.S.

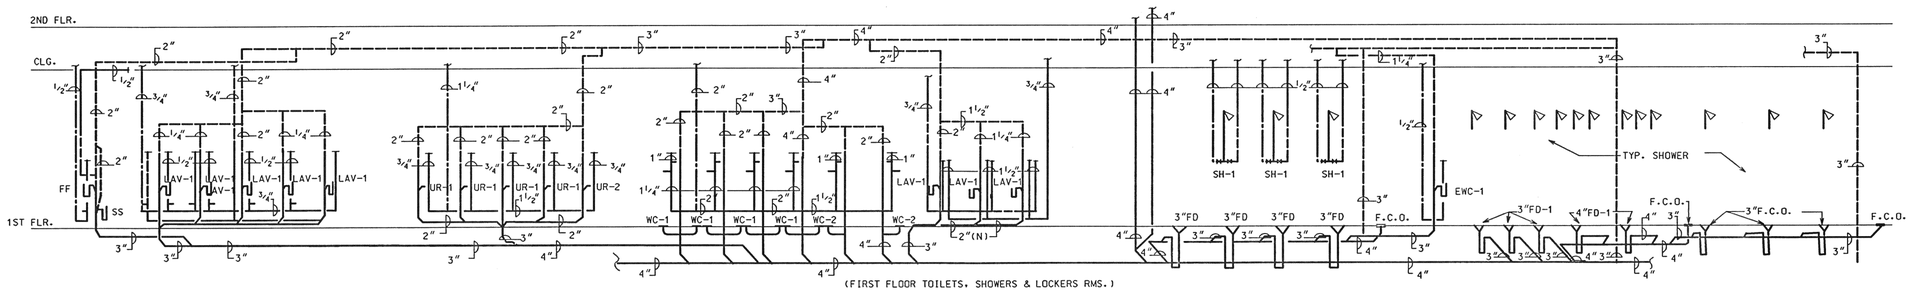

2 PLUMBING RISER DIAGRAM
N.T.S.

RELEASED
Date Rev Init
2-1-07 B

REVISION	DATE	DESCRIPTION			
AS-BUILT	02-5-07	A00076	CoF0205,C82009(FVM)	DYN190533(AM)	COF02106(NAR)

SIGNATURES		DATE
DR.ALEX	ENG REDRAWN	08-21-03
CH	APPR	
REV		
DISCP		
PE		
APPR		

NATIONAL AERONAUTICS & SPACE ADMINISTRATION
LYNDON B. JOHNSON SPACE CENTER HOUSTON, TEXAS
BUILDING 207

PLUMBING RISER DIAGRAMS

PROJECT NO.
PROJECT ID WR
CODE IDENT.NO. 21356
SIZE F
SHEET NO. ___ OF ___
DWG NO. M-207-5

CAD FILE NAME: M207Z5. DGN