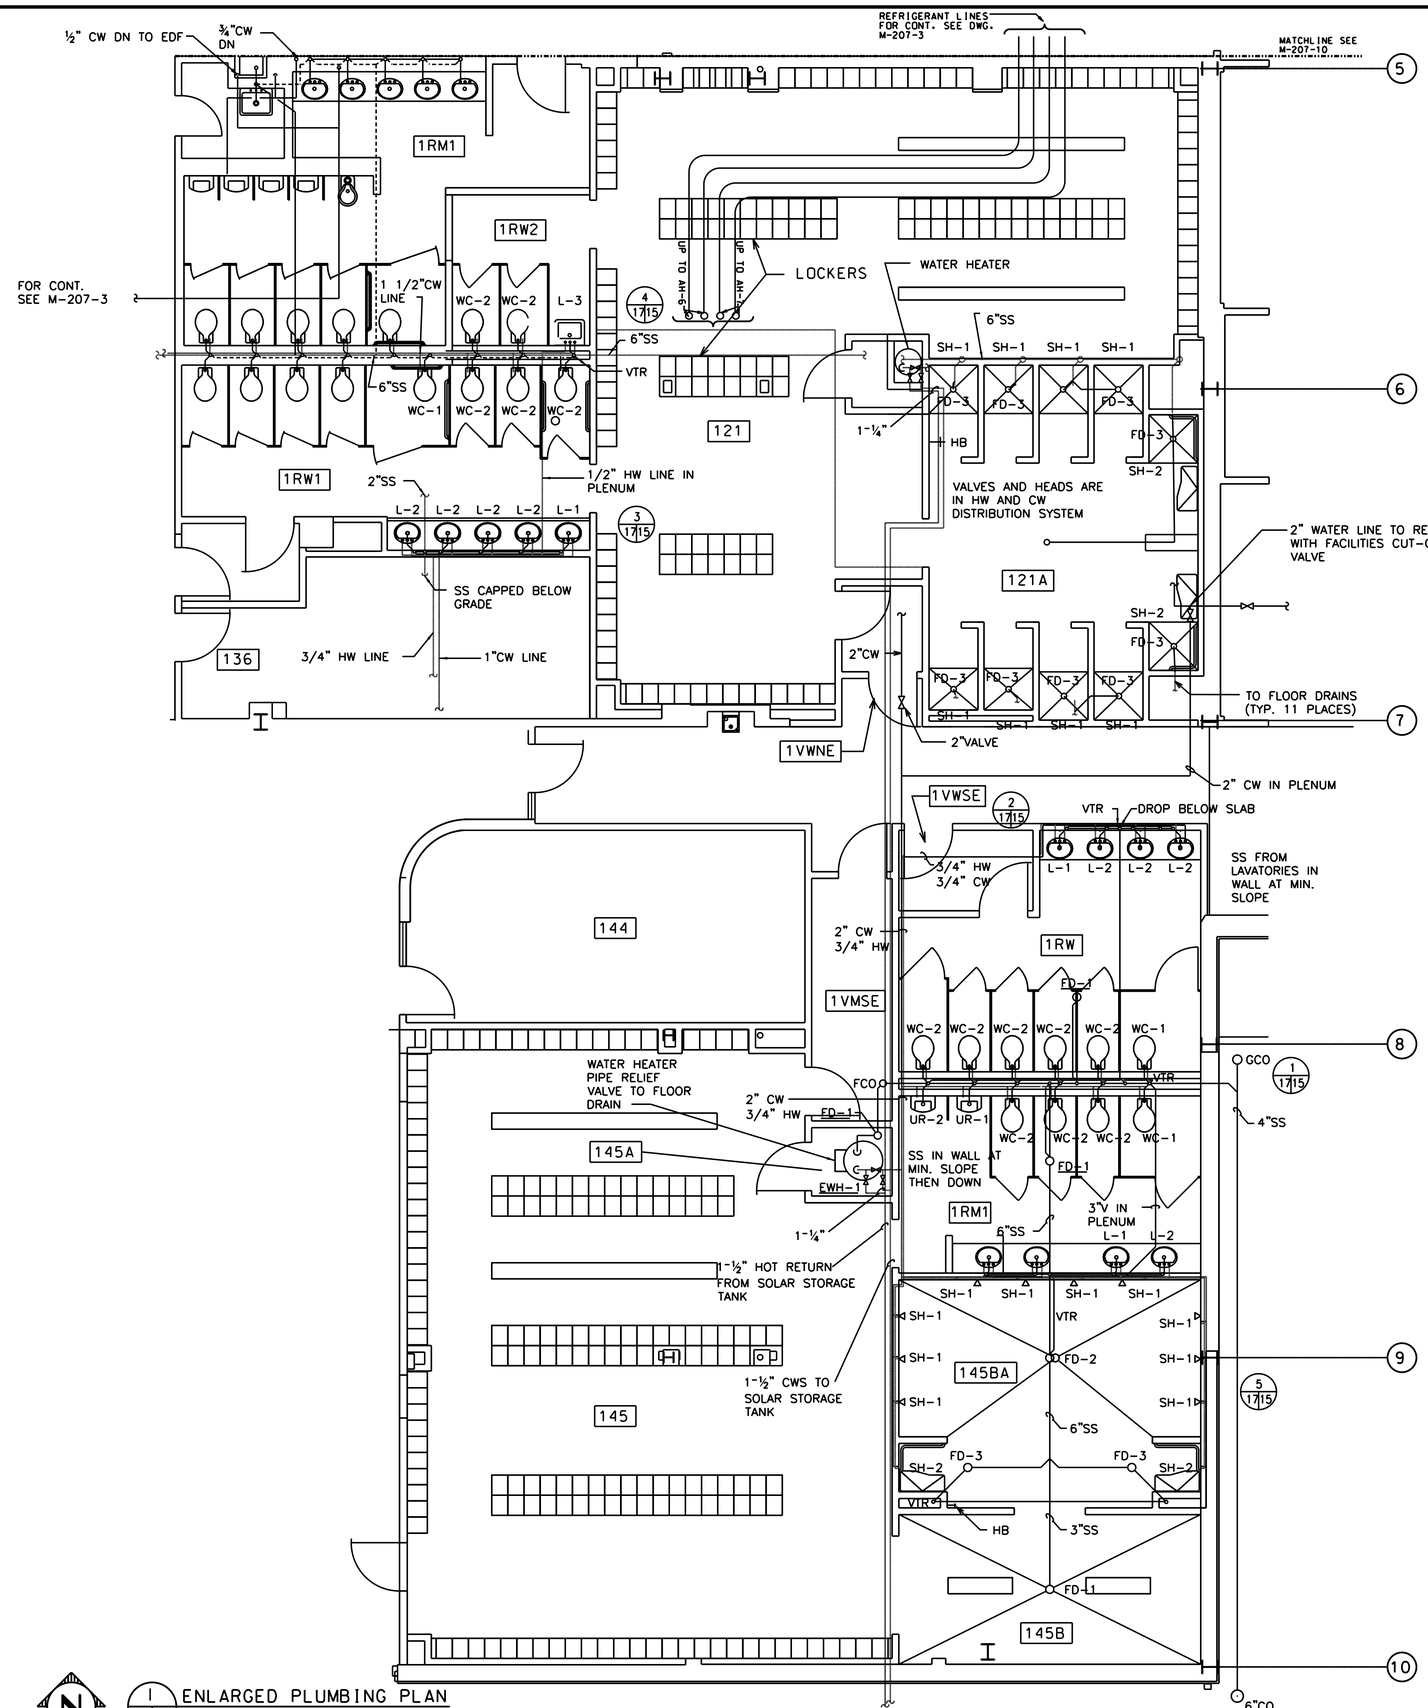

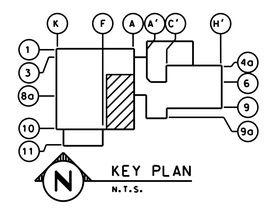

1/4"=1'-0"

GRAPHIC SCALE

CAD FILE NAME: M207Z17. DGN

1 / 3 17 ENLARGED PLUMBING PLAN
SCALE: ¼"=1'-0"

REVISION	DATE	DESCRIPTION
AS-BUILT	02-06-12	COF02106(NAR) W45835(DNJ)

SIGNATURES		DATE
DR. PAG	ENG REDRAWN	01-18-07
CH GJB	APPR GJB	1/30/07
GLENN J. BUNCH		1/30/07
REV		
DISCP		
PE		
APPR C. BENNETT		1/30/07

NATIONAL AERONAUTICS & SPACE ADMINISTRATION
LYNDON B. JOHNSON SPACE CENTER HOUSTON, TEXAS

BUILDING 207

ENLARGED PLUMBING PLAN

PROJECT NO.
PROJECT ID NO.
CODE IDENT. NO. 21450
SIZE F
SHEET NO. ___ OF ___
DWG NO. M-207-17

SDATES STIMES SUSERS SFILESS SFILELS