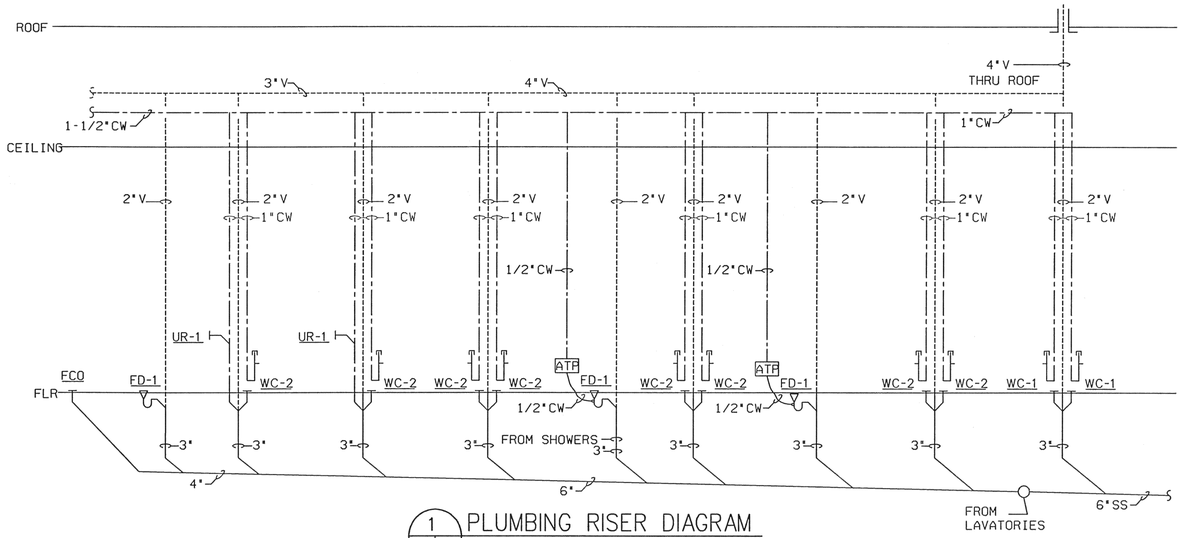

1 / 17|15 PLUMBING RISER DIAGRAM
SCALE: N.T.S.

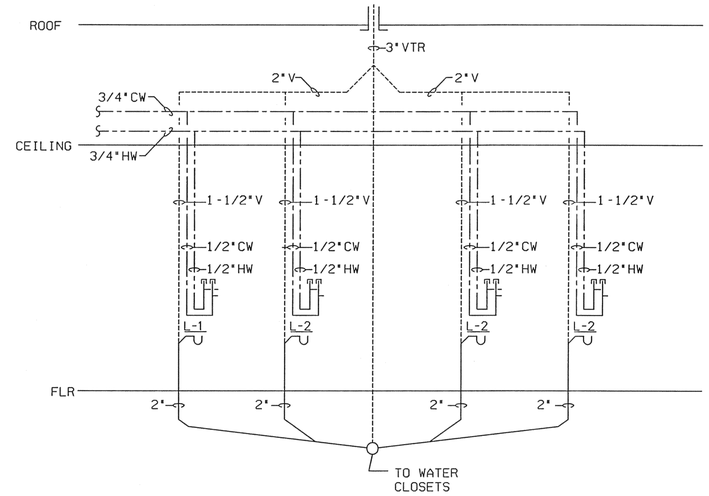

2 / 17|15 PLUMBING RISER DIAGRAM
SCALE: N.T.S.

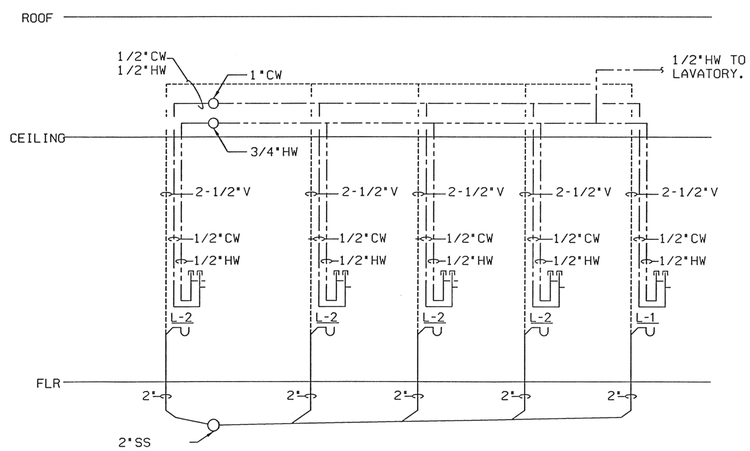

3 / 17|15 PLUMBING RISER DIAGRAM
SCALE: N.T.S.

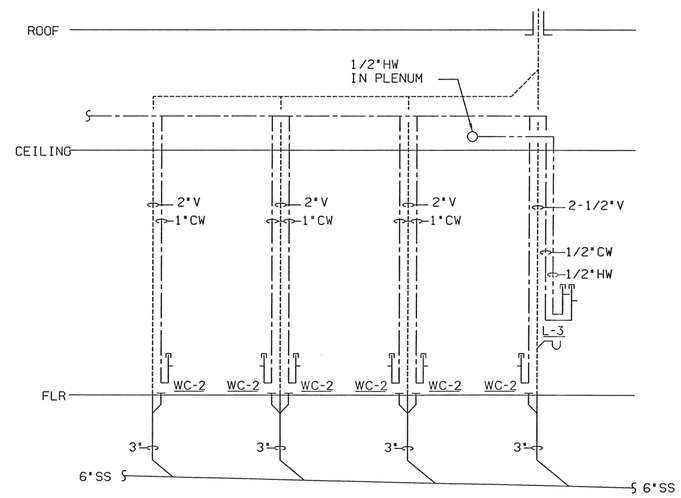

4 / 17|15 PLUMBING RISER DIAGRAM
SCALE: N.T.S.

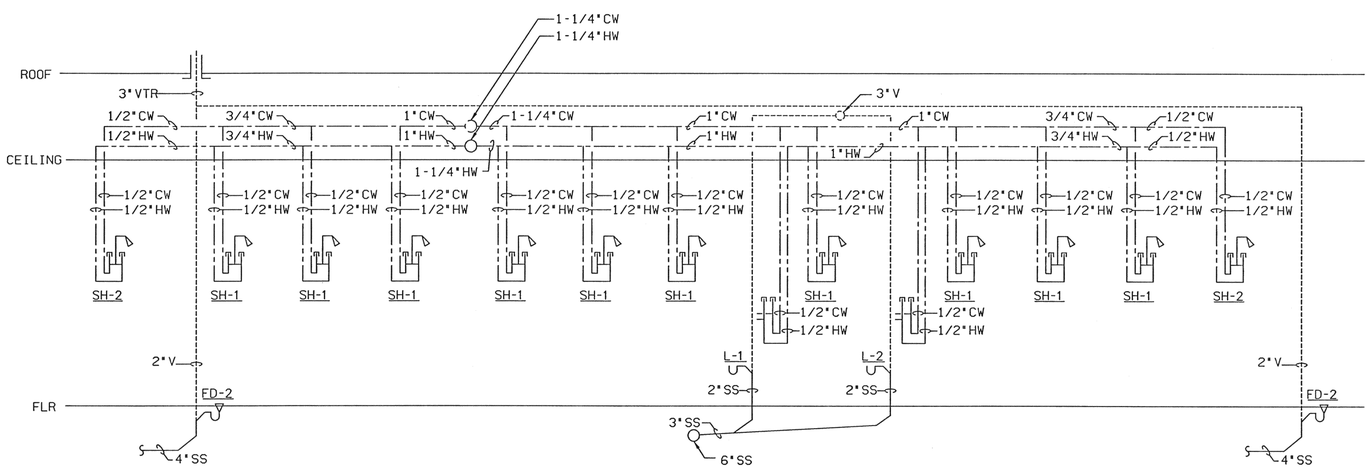

5 / 17|15 PLUMBING RISER DIAGRAM
SCALE: N.T.S.

RELEASED
Date Rev Init
2-5-07 NC

REVISION	DATE	DESCRIPTION
AS-BUILT	2-5-07	CoF02106(NAR)

SIGNATURES		DATE
DR. NAR	ENG REDRAWN	11-17-06
CH GJB	APPR GJB	1-30-07
GLENN J. BUNCH		1-30-07
REV		
DISCP		
PE		
APPR C. BENNETT		2-01-07

NATIONAL AERONAUTICS & SPACE ADMINISTRATION
LYNDON B. JOHNSON SPACE CENTER HOUSTON, TEXAS
BUILDING 207

PLUMBING RISER DIAGRAMS

PROJECT NO. | SHEET NO. ___ OF ___
PROJECT ID | WR
CODE IDENT-NO. 21358 | SIZE E | DWG NO. M-207-15

CAD FILE NAME: M207z15.DGN